Section 36-94-14 2007-1103.
As-ref to in
Fry Te Bok

STEVE BUSSE

P.O. BOX 241

508 ELM STREET

ALLISON, IOWA 50602


(319) 267-2519

UNITED STATES PUBLIC LAND SURVEY CORNER CERTIFICATE

Land Survey Monuments situated in Section: 1 Township: 93 North
Range: 14 West Of the Fifth Principal Meridian, Bremer County, lowa.
Previously recorded in N/A In County Recorder's Office.

Monument Description and Remarks: FOUND 1" AXLE ROD IN CENTER OF INTERSECTION AT NW CORNES SECTION FROM INFORMATION FROM CHICKASAW COUNTY ENGINEERS OFFICE. FOUND 1/2" REBAR AT NORTH 1/4 CORNER. CORNER IS IN LINE WITH FENCE TO NORTH. FOUND FROM INFORMATION FROM CHICKASAW COUNTY ENGINEERS OFFICE. USED CORNERS IN SURVEY IN SECTION 1.

PLAN - VIEW

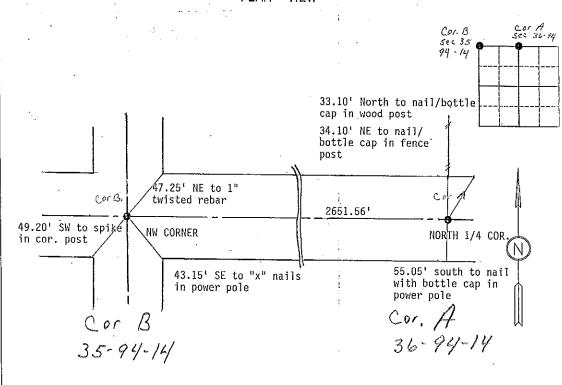



I hereby certify that this land surveying document was prepared and the related survey work was performed by me or under my direct personal supervision and that I am a duly Ecensed Land, Surveyor under the laws of the State of lawa.

STEVE BUSSE

5/78/07 DATE

License number <u>9018</u>

My license renewal date is Dec 31, <u>200 8</u>

Pages or sheets covered by this seal:

	List Co	rners	to	be	Indexed:
	Corners	'Sect.		Тир	Range
	NW cor. North 1/4	1 1		93 93	14 14
-	SW cor. South 1/4	36 36		94 94	14 14

Section 35-94-14
As ref. to in
Engr. The Book

SLSI 9-94

UNITED STATES PUBLIC LAND SURVEY CORNER CERTIFICATE

Land Survey Monuments situated in Section 36	ろ , Township りたんなくない j	94	_, Range			
/4 , of the Fifth Principal Meridian, C Previously recorded in Not Application	HICKAJAW	n County Record	nty, 10wa. ler's Office.			
(Show reason for preparing this certificate, the evidence and detailed procumentation found or placed.) Monument Description and Remarks:		•				
Michael Bootspilot and Society						
PLAN - VIE (Show a minimum of three reference ties to durable physical objects, relea	VY vant monuments and physical	sical conditions that	will enable			
recovery of the corner.) A Nail + both cap			7			
in powerpole W/4 Con						
15 36.50' W/4 Gol W/4 Gol 36-9.	4-14					
Found 1"	(X/e)					
Corc						
35-94-14						
	5/10	, Cab 1	g g ×			
10 un 75	Sec. 3	(CON (G-94-14) 25 2" re-bar ine horth)	X 34 6			
9	"re-bat o	60 g 3 W				
-811	on feacel	ine hort) H	8 7 8			
		Ž.	2.5			
\$ 1" twicks		-	- F -			
1745 re-691		3.10	30			
S.M. Con Sec 36-94.11 E County	Road_	ין ר''	3" "			
	51.74'	1	COYA			
Found 1"axle) 90 16.85 35-94-14			36-94-14			
		90.	· · · · · · · · · · · · · · · · · · ·			
Spike in Cor. Post		ζ,				
COP. 1011		Ø	Nail thothe car in power pole			
I hereby certify that the survey work was completed and this land surveying document was prepared by me or under my direct personal		orners to be Indexed tion Twp	Range .			
supervision and that I am a duly registered land surveyor under the laws of the state of lowa			- 14 8.35			
, .	51/4 3	6 - 94	- / KA-35			
Signature: Harlan K Schuch Name typed or printed: Harlah K Schuck	W.1/x 3	6 - 94	-/4 C-35-74			
Date: 9/13/96 Reg. No. 9962						
My registration renewal date is December 31,		2				
		1 610/ 2	<i>,</i> 0,1			
. SEAL		y y was no	\.)			
	'	1. Ibi	1 ale			
) pued d	10/11/11			
		1.	101 /			
	<u> </u>					