Chickasaw Co. Recorder Cindy Messersmith Fee Book 207/05/2012 @0249PM SCC, SEC COR CERT Page: \$7.00 Fee Book 2012-1331 Book: Total Fees: # Pages: 1

Prepared by & Return to Harold - Reacks Surveying, 10 East Main Street, New Hampton, IA 50059, Ph. 64994-2725

UNITED STATES PUBLIC LAND SURVEY CORNER CERTIFICATE

Land Survey Monuments situated in Section 29, Township 95 North, Range 14 West of the Fifth Principal Meridian, Chickasaw County, Iowa. 1.) Previously recorded in Bk. 2004, Pg. 1396 in the County Recorder's office. 2.) Previously recorded in Bk. 2007, Pg. 0577 in the County Recorder's office.

This certificate is being prepared in compliance with Iowa Code Chapter 355.11 because:

П 182 X There is no certificate on file for this corner. There are no longer three valid ties of record.


There are changes to reference ties of record. There is change of monumentation of record. To clarify description of record monument (ties).

Monument Description and Remarks:

- 1.) Southwest Corner SE 1/4-NW 1/4: Set 1"Ø Bronze Survey Marker PLS 19211 at previous location (Found MAG Nail w/Stainless Steel Washer PLS 16961) by means of coordinates obtained prior to highway reconstruction, Project No. STP-S-CO19(80)--5E-19.
- 2.) Southwest Corner SE 1/4-SW 1/4: Set 1"Ø Bronze Survey Marker PLS 19211 at previous location (Found MAG Nail w/Stainless Steel Washer PLS 11442) by means of coordinates obtained prior to highway reconstruction, Project No. STP-S-CO19(80)--5E

PLAN - VIEW

(Show a minimum of three reference ties to durable physical objects, relevant monuments and physical conditions that will enable recovery of the corner.)

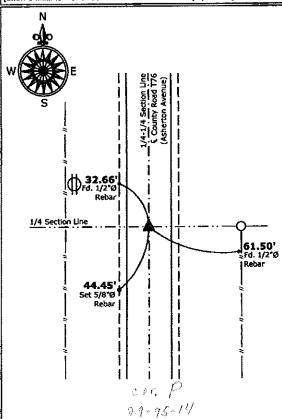

1.) Southwest Corner SE 1/4-NW 1/4 Section 29-95-14 Set 1'Ø Bronze Survey Marker PLS 19211

License number 19211

Sec. 29 T95N **R14W** 29 Chickasaw Twp. County R 68.38 Fd. 5/8*0 Rebai 42.40' Set 5/8'0 Section Line € 240th Street Fd. 5/8°Ø 29-95-14

2.) Southwest Corner SE 1/4-SW 1/4 Section 29-95-14 Set 1"Ø Bronze Survey Marker PLS 19211



I hereby certify that this land surveying document was prepared and the related survey work was performed by me or under my direct personal supervision and that I am a duly licensed Land Surveyor under the laws of the State of Iowa.

D. Recite Kirk D. Reicks

7-5-12	
Date:	

List Corners to be Indexed				
Corners	Section	Twp.	Range	
SW-SE-NW	29	95	14	
SW-SE-SW	29	95	14	
			Į.	

Chickasaw Co. Recorder
Cindy Messersmith
Fee Book 2012-0351
02/16/2012 @0341PM
SCC SEC COR CERT
Fook; Page: \$7.00 # Pages: 1

Prepared by & Return to: Heroid - Reicks Surveying, 10 East Main Street, New Hampton, IA 59659, Ph. 64-994-2725

UNITED STATES PUBLIC LAND SURVEY CORNER CERTIFICATE


Land Survey Monuments situated in Section 29, Township 95 North, Range 14 West of the Fifth Principal Meridian, Chickasaw County, Iowa. 1., 2.) Not previously recorded in the County Recorder's office.

This certificate is being prepared in compliance with Iowa Code Chapter 355.11 because:

1 & 2 ☑ There is no certificate on file for this corner.
☐ There are no longer three valid ties of record.
☐ There are changes to reference ties of record.
☐ There is change of monumentation of record.
☐ To clarify description of record monument (ties).

Monument Description and Remarks:

- 1.) Northwest Corner NE 1/4-NW 1/4: Set 5/8"Ø rebar w/2"Ø aluminum cap PLS 15525 equidistant and online between the Northwest and North 1/4 Corners of Section 29.
- 2.) Southwest Corner SE 1/4-NW 1/4: Set 5/8"Ø rebar w/2"Ø aluminum cap PLS 15525 equidistant and online between the West 1/4 Corner and Center of Section 29.

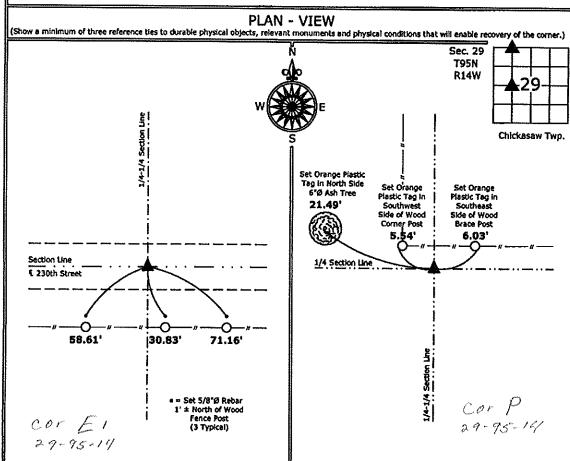

1.) Northwest Corner NE 1/4-NW 1/4 Section 29-95-14 Set 5/8'Ø rebar w/2'Ø aluminum cap PLS 15525 2.) Southwest Corner SE 1/4-NW 1/4 Section 29-95-14 Set 5/8*Ø rebar w/2*Ø aluminum cap PLS 15525



I hereby certify that this land surveying document was prepared and the related survey work was performed by me or under my direct personal supervision and that I am a duly licensed Land Surveyor under the laws of the State of Iowa.

Paul R. Herold 2-15-12

License number 15525

My license renewal date is December 31, 2012. Sheets covered by this seal: Individual sheet only

List Corners to be Indexed				
Corners	Section	Twp.	Range	
NW-NE-NW	29	95	14	
SW-SE-NW	29	95	14	

S:_C3D Projects\2012\2012-013\2012-013.dwg, 2/15/2012 2:37:08

Project Number: 2012-013 FB: Chickasaw County 4, Pg. 32 Section 20-95-14
As referred to in
Engl. Tie Book

FILED 2004-1396
RECORDER'S OFFICE
CHICKASAW COUNTY, 10WA

2004 JUN 18 PM 12 46

CINDY MESSERSMITH COUNTY RECORDER

TEKIPPE ENGINEERING, P.C., 128 South Vine Street, West Union, Iowa 52175 Phone (563) 422-5131 UNITED STATES PUBLIC LAND SURVEY CORNER CERTIFICATE 20 29 , Township _ 95 North, Range Land Survey Monuments situated in Section West of the Fifth Principal Meridian, CHICKASAW County, Iowa. none Previously recorded in _____ ____ in County Recorder's Office. (book, page, document number, etc.) (Show reason for preparing this certificate, the evidence and detailed procedures used in establishing the corner positions and monumentation found or placed.) Monument Description and Remarks: NE Corner NW 1/4 - NW 1/4 Section 29 T95N R14W: Found 1/2" twisted iron bar with information obtained from the Chickasaw County Engineer's Office in Field Book Chickasaw Twp. Corner Ties, Section 20, Corner H1. SW Corner SE 1/4 - NW 1/4 Section 29 T95N R14W: Set MAG nail w/stainless steel washer PLS 16961 using reference ties noted in the Chickasaw County Engineer's Office in Field Book Chickasaw Twp. Corner Ties, Section 29, Corner G1. PLAN - VIEW (Show a minimum of three reference ties to durable physical objects, relevant monuments and physical conditions that will enable recovery of the corner.) Sec. 29 T95N R14W Chickasaw Twp. Set 1/2"# Found 1/2° twisted rebor in shoulder across from power pole Found Found X-noils East side 60.13" power pole 230th St. 61.61. Sec. Line 176) ŖĠ. ပ္ပံ Set 1/2"\$ rebor w/1.5"\$ cluminum cap TeKlope Eng. Control Point Set 1/2"s rebar East of Asherton wer pole brace old toad grade Cor. H, 20-95-14 NE Corner NW 1/4 - NW 1/4 Section 29 T95N R14W SW Corner SE 1/4 - NW 1/4 Section 29 T95N R14W Found 1/2" twisted iron bar Set MAG nail w/stainless steel washer PLS 16961



I hereby certify that this land surveying document was prepared and the related survey work was performed by me or under my direct personal supervision and that I am a duly licensed Land Surveyor under the laws of the State of lows.

Michael J. Shimak June 18,2004

Michael J. Shimak Date

License number 16961

My license renewal date is December 31, 2005. Sheets covered by this seal: Individual

Corners	List Corners Section	to be Indexed Twp.	Range
NE-NW-NW	29	95N	14W
SW-SE-NW	29	95N	14W

X:\Section Corners\Sec. 29\29-95-14bi.dwg Project Number 04137.LS FB. 46L PG. 7-8