Chickasaw Co. Becorder
Cindy Messersmith
Fee Book 2014-1709
12/03/2014 @0255PM
SCC SEC COR CERT
Book: Page: \$7.00 # Pages: 1

Prepared by & Return to: Herold - Reicks Surveying, 10 East Main Street, New Hampton, 19 50659, Ph. 641-394-2725

## UNITED STATES PUBLIC LAND SURVEY CORNER CERTIFICATE

Land Survey Monuments situated in Section 14, Township 95 North, Range 13 West of the Fifth Principal Meridian, Chickasaw County, Iowa. 1. and 2.) Previously not recorded in the County Recorder's office.

This certificate is being prepared in compliance with Iowa Code Chapter 355.11 because:

There is no certificate on file for this corner.


☐ There are no longer three valid ties of record.
☐ There are changes to reference ties of record.
☐ There is change of monumentation of record.
☐ To clarify description of record monument (ties).

Monument Description and Remarks:

- 1.) Northwest Corner: Found 5/8"Ø rebar from information obtained from the County Engineers office in Field Book Dayton Twp. Corner Ties, Section 10, Corner \*B\*
- 2.) Northwest Corner NE 1/4 NW 1/4: Set Survey Mark Nail w/Stainless Steel Washer PLS 15525 equidistant and online between the Northwest and North 1/4 Corners of Section 14-95-13, there are no records of the perpetuation of a monument at this position.

## PLAN - VIEW

(Show a minimum of three reference ties to durable physical objects, relevant monuments and physical conditions that will enable recovery of the corner.)

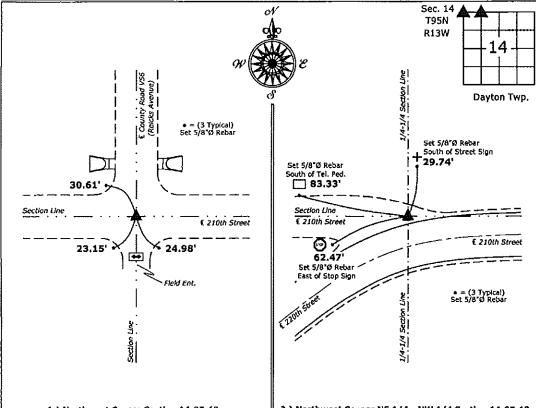

1.) Northwest Corner Section 14-95-13 Found 5/8\*Ø rebar 2.) Northwest Corner NE 1/4 - NW 1/4 Section 14-95-13 Set Survey Mark Nail w/Stainless Steel Washer PLS 15525



I hereby certify that this land surveying document was prepared and the related survey work was performed by me or under my direct personal supervision and that I am a duly licensed Land Surveyor under the laws of the State of Iowa.

Paul R. Herold Date:

License number 15525

My license renewal date is December 31, 2014. Sheets covered by this seal: Individual sheet only

List Comers to be Indexed				
Corners	Section	Twp.	Range	
NW	14	95	13	
WY-NE-NW	14	95	13	

Control Systems/CHICKASAW/CHICK-28 (New

Project Number: 2014-240 FB: Chickasaw County 7, Pgs. 12-13

## UNITED STATES PUBLIC LAND SURVEY CORNER CERTIFICATE SLS19-90

OF

	Or .				
	Land Survey Monuments situated in Section 22 , Township 95 North, Range 13 West of the Fifth Principal Meridian, Chickasaw County Jowa				
	Previously recorded in N/A in County, 1004.				
	(Show reason for preparing this certificate, the evidence and detailed procedures used in establishing the corner positions and monumentation found or placed.)				
Section 15-95-13 as referred to in myr. Tie Book	Monument Description and Remarks: Found corner as listed below				
referred to in					
Tic South					
WHA.					
	PLAN - VIEW  (Show a minimum of three reference ties to durable physical objects, relevant monuments and physical conditions that will enable recovery of the corner.)				
	wood post				
·	power pole				
	steel post 0 34.85:				
	existing fence				
	Cor B 15-95-13				
	Northeast corner Found nail over spike				
	I hereby certify that the survey work was completed and this certificate  List Corners to be Indexed				
	I am a duly registered land surveyor under the laws of the state of				
	Iowa.  NE cor. 22 95 13  Signature:				
	Date: 2/25/92 Reg. No. 9018				
	Of prof 3/6/9/AM				
	Name typed or printed:  Steve Busse  Date: 2/25/92 Reg. No. 9018  SEAL  SEAL  On 16				
	9016				
	100 to				