Chickasaw Co. Recorder Cindy Messersmith Fee Book 2010-0594 04/29/2010 @1025AM SEC OR CERT Book: Page: \$9.00 # Pages: 1

TEKIPPE ENGINEERING, P.C., 128 South Vine Street, West U	Union, Iowa 52175 Phone (563) 422-5131
UNITED STATES PUBLIC LAND SUR	
OF	
Land Survey Monuments situated in Section18	
West of the Fifth Principal Meridian,	Chickesaw County, Iowa.
Previously recorded in (1) none (2) 8k. 171, Pg. (book, page, document number,	in County Recorder's Office.
(Show reason for preparing this certificate, the evidence and	
the corner positions and monumentation found or placed.)	•
Monument Description and Remarks: (1) SE Corner of SW-SW of Section 18-T95N-R13W:	
Found P-K nail from Chickosaw County Engineer's ties, dated 11/25/08, on file in the Chickosaw County Engineer's	
office, New Hampton, Iowa.	
(A) 05 0	No. of the second secon
(2) SE Corner of Section 18—T95N—R13W: Found P—K noil, updating certificate because monument has change	nged and one tie was missing from current
certificate of record, added one new tie.	
PLAN VIE	Project Number 101046.LS Field Book: 46M, Page 67
Show a minimum of three reference ties to dur	rable physical objects, relevant
monuments and physical conditions that will er	enable recovery of the corner.
2	Dayton
⊐' §i	Twp.
1/4-1/4 Section Line	
7	Found X Noils in Power Pote
Found 1/2°s Rebar	[2
\	
	Piastic Tag LS 7060 in
Ø) ‡	Power Pole
220th St. (Co. Rd. B57)	·
Section Line	220th St. (Co. Rd. 857)
	Section Line
2	25.62'
ā F	B B Found Orange Picstic Tag
	LS 7060 In East Side East Sign Post
Found 1/2*s Rebor W/fellow Plastic Cap Chickosow County Chickosow County Chickosow County	con B
Chickasaw County	C D H W
	(2) SE Corner of Sec. 18-T95N-R13W
(1) SE Corner of SW1/4-SW1/4 of Sec. 18-T95N-R13W Found P-K Nail	Found P-K Noil
	List Corners to be Indexed
I hereby certify that this land surveying documen prepared and the related survey work was perform	rmed by Company Section Two Renge
me or under my direct personal supervision and am a duly licensed Land Surveyor under the laws	that I
State of lowo.	3E 01 311-311 10 9014 1311

Lye G. Tekippe

License Number 7060 My license renewal date is December 31, 2010. Sheets covered by this seal: Individual

95N

SE


4-28-10

18 18

X:\Section Corners\Sec. 18\18-95-13VY.dwg

13W

COUNTY ENGINEER'S SECTION CORNER PRESERVATION RECORD

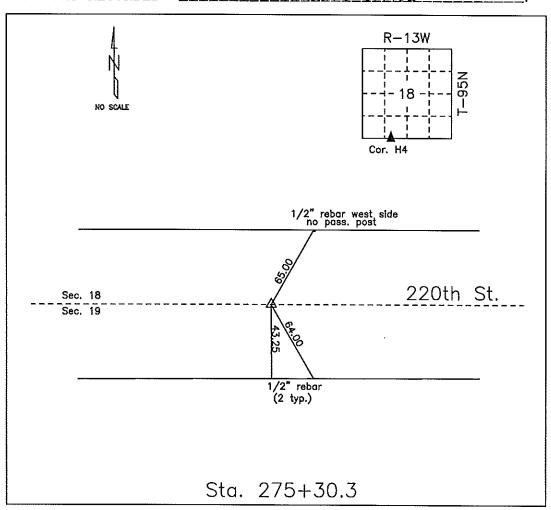

MONUMENT DESCRIPTION AND NARRATIVE Set PK noil in mot 11/25/08

Previously recorded as PT Sta. 275+30.3 in Chickasaw County Project Plans SN-1615(4)--51-19

All ties are slope chained.

I AM NOT A REGISTERED LAND SURVEYOR UNDER THE LAWS OF THE STATE OF IOWA

JIM FOSTER CHICKASAW CO. DATE: 11/25/08