

Prepared by & Return to: Herold - Recks Surveying, 10 East Main Street, New Hampton, IA 50659, Ph. 641-394-2725

**UNITED STATES PUBLIC LAND SURVEY CORNER CERTIFICATE**

Land Survey Monuments situated in Section 4, Township 95 North, Range 13 West of the Fifth Principal Meridian, Chickasaw County, Iowa. Not previously recorded in the County Recorder's office.

This certificate is being prepared in compliance with Iowa Code Chapter 355.11 because:

- 1 & 2  There are no certificates on file for these corners.  
 There are no longer three valid ties of record.  
 There are changes to reference ties of record.  
 There is change of monumentation of record.  
 To clarify description of record monument (ties).


Monument Description and Remarks:

- 1.) SW Corner: Fd. Survey Mark Nail w/I.D.O.T. Stainless Steel Washer.
- 2.) S 1/4 Corner: Fd. Survey Mark Nail w/I.D.O.T. Stainless Steel Washer.

Note: Corners were recovered from information obtained from the Iowa Department of Transportation, As-Built Plans Project No. FR-18-7(31)--26-19, the previous Alum. Disks were replaced after an HMA Overlay Project.

**PLAN - VIEW**

(Show a minimum of three reference ties to durable physical objects, relevant monuments and physical conditions that will enable recovery of the corner.)

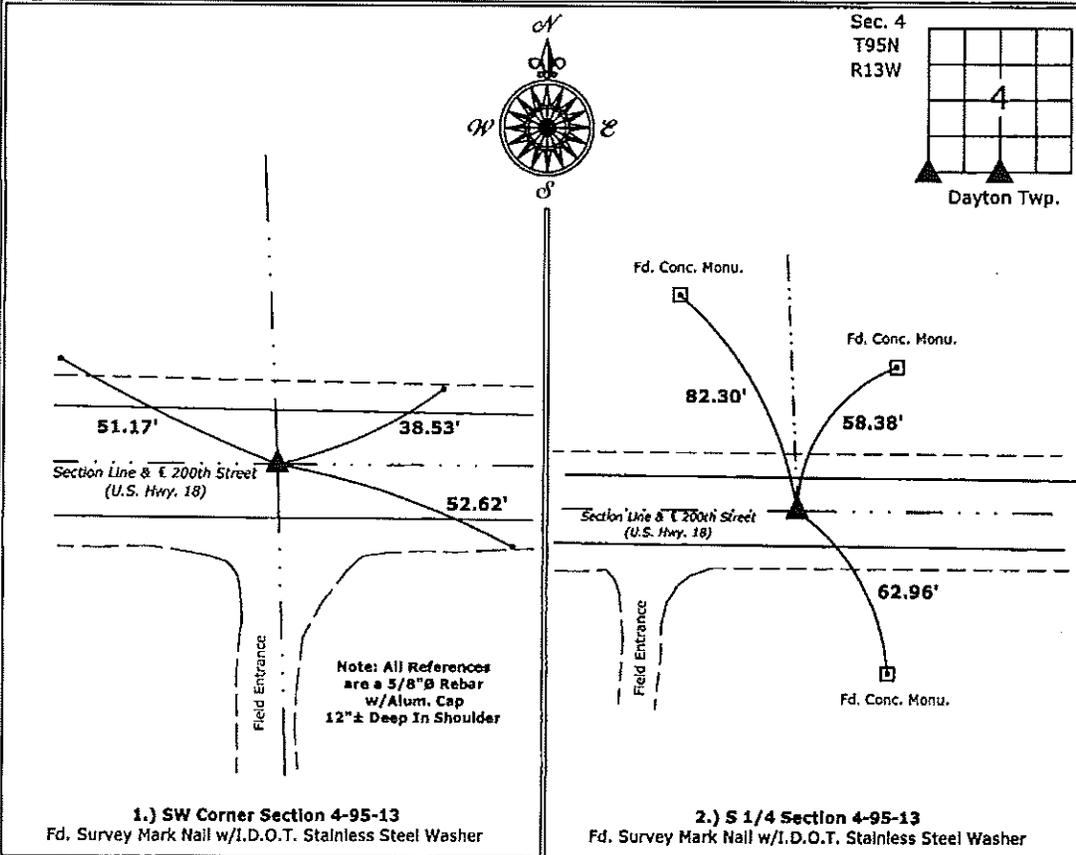

1.) SW Corner Section 4-95-13  
 Fd. Survey Mark Nail w/I.D.O.T. Stainless Steel Washer

2.) S 1/4 Section 4-95-13  
 Fd. Survey Mark Nail w/I.D.O.T. Stainless Steel Washer



I hereby certify that this land surveying document was prepared and the related survey work was performed by me or under my direct personal supervision and that I am a duly licensed Land Surveyor under the laws of the State of Iowa.  
Paul R. Herold 7-8-14  
 Paul R. Herold Date:  
 License number 15525  
 My license renewal date is December 31, 2014.  
 Sheets covered by this seal: Individual sheet only

List Corners to be Indexed			
Corners	Section	Twp.	Range
SW	4	95	13
S 1/4	4	95	13

Project Number: 2014-045

FB: Chickasaw County 6, Pgs. 31-34