
COUNTY ENGINEER'S SECTION CORNER PRESERVATION RECORD

LAND SURVEY MONUMENT LOCATED IN SECTION ____O1_, TOWNSHIP_96_N NORTH, RANGE __14_W___, OF THE 5TH P.M._Chickggw_county, IOWA PREVIOUSLY RECORDED ____COUNTY_ENGINEER'S OFFICE______.

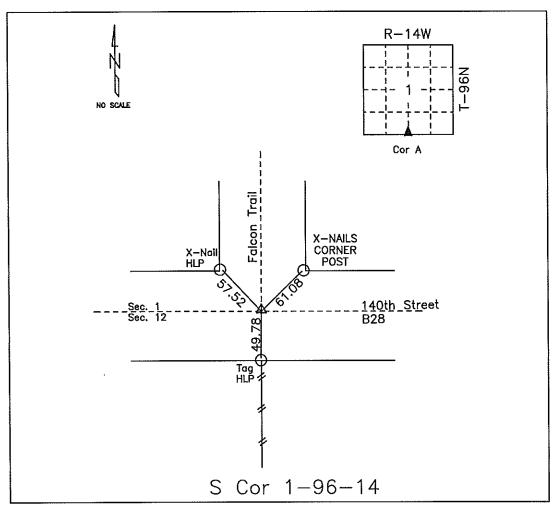

MONUMENT DESCRIPTION AND NARRATIVE Set PK-Nail 05/19/09. Previously recorded by

Steve Busse in Book 2000, page 1500. See also project LC-370--73-19, station 289+57.8.

All ties are slope chained.

I AM NOT A REGISTERED LAND SURVEYOR UNDER THE LAWS OF THE STATE OF IOWA

JIM FOSTER CHICKASAW CO. DATE: 05/19/09

DOCUMENT IN. COLOR STATES STATE	STEVE BUSSE P.O. BOX 241 508 ELM STREET ALLISON, IOWA 50602 319-267-2519 UNITED STATES PUBLIC LAND SURVEY CORNER CERTIFICATE and Survey Monuments situated in Section		11	٠٠	El			
STEVE BUSSE P.O. BOX 241 508 ELM STREET ALLISON, IOWA 50602 319-267-2519 UNITED STATES PUBLIC LAND SURVEY CORNER CERTIFICATE Land Survey Monuments situated in Section / Township 96 North , Range If wast of the Fifth Principal Meridian, CHICKASAW County, Iowa. Previously recorded in NA in County, Iowa. Previously recorded in NA in County, Iowa. Previously recorded in NA in County, Iowa. In County, I	STEVE BUSSE P.O. BOX 241 508 ELM STREET ALLISON, IOWA 50802 319-267-2619 UNITED STATES PUBLIC LAND SURVEY CORNER CERTIFICATE and Survey Monuments situated in Section / Township 96 North, Range If west of the Fifth Principal Meridian, CHICKASAW County, Iowa. Previously recorded in N/ago, document number, etc.) (Show reason for preparing this certificate, the evidence and detailed procedures used in establishing the corner positions and monumentation found or piaced.) Monument Description and Remarks: Found twisted reber at center of interestien or N/A corner. Found Mul magnifications that will anable recovery of the corner) PLAN - VIEW (Show a minimum of three reference tes to durable physical objects, relevant monuments and physical conditions that will anable recovery of the corner) PLAN - VIEW (Show a minimum of three reference tes to durable physical objects, relevant monuments and physical conditions that will anable recovery of the corner) PLAN - VIEW (Show a minimum of three reference tes to durable physical objects, relevant monuments and physical conditions that will anable recovery of the corner) PLAN - VIEW (Show a minimum of three reference tes to durable physical objects, relevant monuments and physical conditions that will anable recovery of the corner) Cor A 36-97-14 130 th	BOCUMENT No. 150	FILED FOR RECORD THEAugust	29th	DAY OF	STATE OF IONA, CHICKA	MANGAMA	Hh same
UNITED STATES PUBLIC LAND SURVEY CORNER CERTIFICATE Land Survey Monuments situated in Section	UNITED STATES PUBLIC LAND SURVEY CORNER CERTIFICATE and Survey Monuments situated in Section / Township 96 North. Range If west of the Fifth Principal Meridian, CHICKASAW County, lowa. Previously recorded in Na in County Recorder's Office. (book, page, document number, etc.) (Show reason for preparing this certificate, the evidence and detailed procedures used in establishing the corner positions and monumentation found or placed.) Monument Description and Remarks: Found twisted rebar at center of interestion at NIA corner Found and applicat at center of interestion at NIA corner Found and application and physical conditions that will enable recovery of the corner) PLAN - VIEW (Show a minimum of three reference lies to durable physical objects, relevant monuments and physical conditions that will enable recovery of the corner) PLAN - VIEW (Show a minimum of three reference lies to durable physical objects, relevant monuments and physical conditions that will enable recovery of the corner) PLAN - VIEW (Show a minimum of three reference lies to durable physical objects, relevant monuments and physical conditions that will enable recovery of the corner) PLAN - VIEW (Show a minimum of three reference lies to durable physical objects, relevant monuments and physical conditions that will enable recovery of the corner) Cor A 100	RECORDING FEE \$			PAGE 1500	JAGUL	The Tra	dYk_ Dest
Land Survey Monuments situated in Section	And Survey Monuments situated in Section	STEVE BUSSE P	.O. BOX 241 508 EL	.M STREET	ALLISON, IO	WA 50602	319-267-2519	
Previously recorded in N/A in Country, lowa. In Country Recorder's Office. (Show reason for preparing this certificate, the evidence and detailed procedures used in establishing the corner positions and menumentalish found or placed.) Monument Description and Remarks: Found full standard rebar at center of Interest and N/A corner. PLAN - VIEW (Show a minimum of three reference lies to durable physical objects, relevant monuments and physical conditions that will enable recovery of the corner) PLAN - VIEW (Show a minimum of three reference lies to durable physical objects, relevant monuments and physical conditions that will enable recovery of the corner) Sco. 25' NE fo''X'' nails in poke 14, 25'' Nw fo''X'' nails cor post 14, 26''' Nw fo''X'' nails cor post 14, 25'' Nw fo''X'' nails in poke 25''X'' nails in poke 25''X''' nails in poke 25''X''' nails in poke 25''X''' nails in poke 25''X''''' nails in poke 25''	Thereby certify that the survey work was completed and this land surveying document was prepared by the state of love. Thereby certify that the survey work was completed and this land surveying document was prepared by the state of love. Thereby certify that the survey work was completed and this land surveying document was prepared by the state of love. Thereby certify that the survey work was completed and this land surveying document was prepared by the state of love. Thereby certify that the survey work was completed and this land surveying document was prepared by the state of love. Thereby certify that the survey work was completed and this land surveying document was prepared by the state of love. Signature: Signat	UNITED	STATES PUBLIC	LAND SU	JRVEY COR	NER CERT	IFICATE	
Previously recorded in (book, page, document number, etc.) (Show reason for preparing this certificate, the evidence and detailed procedures used in establishing the corner positions and monumentation found or piaced.) Monument Description and Remarks: Found trusted rebar at canter of intercection at N'th corner. Found multiple and manufacture at a sarker late black-trap at South the corner. PLAN - VIEW (Show a minimum of three reference lies to durable physical objects, relevant monuments and physical conditions that will enable recovery of the corner) PLAN - VIEW (Show a minimum of three reference lies to durable physical objects, relevant monuments and physical conditions that will enable recovery of the corner) PLAN - VIEW (Show a minimum of three reference lies to durable physical objects, relevant monuments and physical conditions that will enable recovery of the corner) Soc. 20' 3E fo "X" nails in brace post 45.25' NW fo "X" nails cor post 47.25' NW fo "X" nails cor post 66.00' NE to "X" nai	Previously recorded in book, age, document number, etc.) (Show reason for preparing this certificate, the evidence end detailed procedures used in establishing the corner positions and monumentation found or placed.) Monument Description and Remarks: Found twisted rebar at center of material and the secretary at NH2 corner. Found multiple and marginality at center of material and physical conditions that will enable recovery of the corner) PLAN - VIEW (Show a minimum of three reference lies to durable physical objects, relevent monuments and physical conditions that will enable recovery of the corner) Cor A 36-97-14 130 the secretary of the corner) Cor A 36-97-14 130 the secretary of the corner of t	Land Survey Monu	ments situated in Sec	tlon	, Towr	eship <u>96 A</u>	orth Ran	ge
(Show reason for preparing this certificate, the evidence end detailed procedures used in establishing the corner positions and monumentation found or placed.) Monument Description and Remarks: Found fursted rate at center of intersection at NIA corner. Monument Description and Remarks: Found fursted rate at center of intersection at NIA corner. PLAN - VIEW (Show a minimum of three reference lies to durable physical objects, relevant monuments and physical conditions that will enable recovery of the corner) PLAN - VIEW (Show a minimum of three reference lies to durable physical objects, relevant monuments and physical conditions that will enable recovery of the corner) So. 25' NE fo" X" nails in brace post 45.25' NW fo "X" nails in brace post 49.25' NW fo "X" nails in brace post 49.25' NW fo "X" nails cor post 61.00' NE fo" "X" nails cor post 49.30' tag in power pole So. I hereby certify that the survey work was completed and this land surveying document was prepared by me or under my direct personal supervision and that I am a duly licensed land surveyor under the laws of the state of lows Signature: Name typed or printed: Signature: Signature: Name typed or printed: Signature: Signa	(Show a minimum of three reference ties to durable physical objects, relevant monuments and physical conditions that will enable recovery of the corner) PLAN - VIEW (Show a minimum of three reference ties to durable physical objects, relevant monuments and physical conditions that will enable recovery of the corner) PLAN - VIEW (Show a minimum of three reference ties to durable physical objects, relevant monuments and physical conditions that will enable recovery of the corner) PLAN - VIEW (Show a minimum of three reference ties to durable physical objects, relevant monuments and physical conditions that will enable recovery of the corner) PLAN - VIEW (Show a minimum of three reference ties to durable physical objects, relevant monuments and physical conditions that will enable recovery of the corner) So. 75' NE TO''X'' nails in brace post 45.25' New To''X'' nails in brace post 49.25' New To''X'' nails in brace post 49.30' tag in power pole So. And the start of lowe Signature: Signature:	14 west	_, of the Fifth Principa	ıl Meridlan, _	CHICKASA	عين	County, low	/a.
(Show reason for preparing this certificate, the evidence end detailed procedures used in establishing the corner positions and monumentation found or placed.) Monument Description and Remarks: Found fursted rate at center of intersection at NIA corner. Monument Description and Remarks: Found fursted rate at center of intersection at NIA corner. PLAN - VIEW (Show a minimum of three reference lies to durable physical objects, relevant monuments and physical conditions that will enable recovery of the corner) PLAN - VIEW (Show a minimum of three reference lies to durable physical objects, relevant monuments and physical conditions that will enable recovery of the corner) So. 25' NE fo" X" nails in brace post 45.25' NW fo "X" nails in brace post 49.25' NW fo "X" nails in brace post 49.25' NW fo "X" nails cor post 61.00' NE fo" "X" nails cor post 49.30' tag in power pole So. I hereby certify that the survey work was completed and this land surveying document was prepared by me or under my direct personal supervision and that I am a duly licensed land surveyor under the laws of the state of lows Signature: Name typed or printed: Signature: Signature: Name typed or printed: Signature: Signa	(Show a minimum of three reference ties to durable physical objects, relevant monuments and physical conditions that will enable recovery of the corner) PLAN - VIEW (Show a minimum of three reference ties to durable physical objects, relevant monuments and physical conditions that will enable recovery of the corner) PLAN - VIEW (Show a minimum of three reference ties to durable physical objects, relevant monuments and physical conditions that will enable recovery of the corner) PLAN - VIEW (Show a minimum of three reference ties to durable physical objects, relevant monuments and physical conditions that will enable recovery of the corner) PLAN - VIEW (Show a minimum of three reference ties to durable physical objects, relevant monuments and physical conditions that will enable recovery of the corner) So. 75' NE TO''X'' nails in brace post 45.25' New To''X'' nails in brace post 49.25' New To''X'' nails in brace post 49.30' tag in power pole So. And the start of lowe Signature: Signature:	Previously recorded	d in			in County R	ecorder's Off	ice.
Intersection of N/4 corner. Found and applicat of center line black-top at South 14 corner. PLAN - VIEW (Show a minimum of three reference lies to durable physical objects, relevant monuments and physical conditions that will enable recovery of the corner) PLAN - VIEW (Show a minimum of three reference lies to durable physical objects, relevant monuments and physical conditions that will enable recovery of the corner) PLAN - VIEW (Show a minimum of three reference lies to durable physical objects, relevant monuments and physical conditions that will enable recovery of the corner) PLAN - VIEW (Show a minimum of three reference lies to durable physical objects, relevant monuments and physical conditions that will enable recovery of the corner) PLAN - VIEW (Show a minimum of three reference lies to durable physical objects, relevant monuments and physical conditions that will enable recovery of the corner) PLAN - VIEW (Show a minimum of three reference lies to durable physical objects, relevant monuments and physical conditions that will enable recovery of the corner) PLAN - and physical objects, relevant monuments and physical conditions that will enable physical objects, relevant monuments and physical objec	Interestion of N/4 corner. Found and asplat of center line blacktop at South //4 corner. PLAN - VIEW (Show a minimum of three reference lies to durable physical objects, relevant monuments and physical conditions that will enable recovery of the corner) Cor A 36-97-14 130 th 50. 05' NE fo" x" nails in con post 50. 20' 3E fo "x" nails in brace post 49.25' Nw fo "x" nails in brace post 49.25' Nw fo "x" nails cor post 61.00' NE fo "x" nails cor post 61.00' NE fo "x" nails cor post 61.00' NE fo "x" nails cor post 49.80' fag in power pole. So. 796-14 Thereby certify that the survey work was completed and this land surveying document was prepared by me or under my direct personal supervision and that is and surveying under the laws of the state of lowa Signature: Signature: Name typed or printed STORE 80.05 90.06 140 Signature: Name typed or printed STORE 80.05 90.06 My license renewal date is December 31, 2000	(Show reason for prepared monumentation for	aring this certificate, the ev and or pisced.)	ridence end de	lalled procedures	used in establis	hing the corner	positions
(Show a minimum of three reference ties to durable physical objects, relevant monuments and physical conditions that will enable recovery of the corner) PLAN – VIEW (Show a minimum of three reference ties to durable physical objects, relevant monuments and physical conditions that will enable recovery of the corner) Cor A 36-97-14 130	PLAN - VIEW (Show a minimum of three reference lies to durable physical objects, relevant monuments and physical conditions that will enable recovery of the corner) So. 05' NE to "X" nails in don post sec. 36-36-36-36-36-36-36-36-36-36-36-36-36-3							
(Show a minimum of three reference lies to durable physical objects, relevant monuments and physical conditions that will enable recovery of the corner) Cor A 36-97-14 130 th 50.05' NE fo"X" nails in con post 50.20' 3E fo"X" nails in pole 45.25' 3ut to iron pin 56.75' Nu to "X" nails in brace post 49.25' Nu to "X" nails con post 61.35' Nu to "X" nails con post 49.80' fag in power pole So. I hereby certify that the survey work was completed and this land surveying document was prepared by me or under my direct personal supervision and that I am a duly licensed land surveyor under the laws of the state of lowe Signature: Neme typed or printed Seguino 2018 My license renewal date, is December 31, 2000 My license renewal date, is December 31, 2000	(Show a minimum of three reference lies to durable physical objects, relevant monuments and physical conditions that will enable recovery of the corner) Cor A 36-97-14 130 th So. 05' NE fo" x" nails in con post 50. 20' 3E fo "x" nails in pole 45. 25' 35 to treen pin 49. 25' Nw fo "x" nails in brace post 49. 25' Nw fo "x" nails in brace post 49. 80' fag in power pole 50. Thereby certify that the survey work was completed and this land surveying document was prepared by me or under my direct personal supervision and that I am a duly licensed land surveyor under the laws of the state of lowa Signature: Neme typed or printed Signature: Susse My license renewal date is December 31, 2000 My license renewal date is December 31, 2000							
(Show a minimum of three reference lies to durable physical objects, relevant monuments and physical conditions that will enable recovery of the corner) Cor A 36-97-14 130 th 50.05' NE fo"X" nails in con post 50.20' 3E fo"X" nails in pole 45.25' 3ut to iron pin 56.75' Nu fo "X" nails in brace post 49.25' Nu fo "X" nails cor post 61.00' NE fo"X" nails cor post 49.80' fag in power pole So. I hereby certify that the survey work was completed and this land surveying document was prepared by me or under my direct personal supervision and that I am a duly licensed land surveyor under the laws of the state of lowe Signature: Name typed or printed Seg No. 20/8 My license renewal date, is December 31, 2000 My license renewal date, is December 31, 2000	(Show a minimum of three reference lies to durable physical objects, relevant monuments and physical conditions that will enable recovery of the corner) Cor A 36-97-14 130 th So. 05' NE fo" x" nails in con post 50. 20' 3E fo "x" nails in pole 45. 25' 35 to treen pin 49. 25' Nw fo "x" nails in brace post 49. 25' Nw fo "x" nails in brace post 49. 80' fag in power pole 50. Thereby certify that the survey work was completed and this land surveying document was prepared by me or under my direct personal supervision and that I am a duly licensed land surveyor under the laws of the state of lowa Signature: Neme typed or printed Signature: Susse My license renewal date is December 31, 2000 My license renewal date is December 31, 2000							
(Show a minimum of three reference lies to durable physical objects, relevant monuments and physical conditions that will enable recovery of the corner) Cor A 36-97-14 130 th 50.05' NE fo"x" nails in con post 50.20' 3E fo"x" nails in pole 45.25' 3ut to iron pin 56.75' Nu fo "x" nails in brace post 49.25' Nu fo "x" nails con post 61.35' Nu fo "x" nails con post 61.00' NE fo "x	(Show a minimum of three reference lies to durable physical objects, relevant monuments and physical conditions that will enable recovery of the corner) Cor A 36-97-14 130 th So. 05' NE fo" x" nails in con post 50. 20' 3E fo "x" nails in pole 45. 25' 35 to treen pin 49. 25' Nw fo "x" nails in brace post 49. 25' Nw fo "x" nails in brace post 49. 80' fag in power pole 50. Thereby certify that the survey work was completed and this land surveying document was prepared by me or under my direct personal supervision and that I am a duly licensed land surveyor under the laws of the state of lowa Signature: Neme typed or printed Signature: Susse My license renewal date is December 31, 2000 My license renewal date is December 31, 2000					,		the state of the s
Thereby certify that the survey work was completed and this land surveying document was prepared by me or under my direct personal supervision and that i am a duly licensed land surveyor under the laws of the state of lows Signature:	Thereby certify that the survey work was completed and this land surveying document was prepared by me or under my direct personal supervision and that I am a duly licensed land surveyor under the laws of the state of lowa Signature: Date: B/21/DD Reg No. 90(B My license renewal date is December 31, 2000 So. 05' NE fo" X" nails in con post 50. 20' X" nails cor post 45. 25' Xw to "x" nails cor post 61.35' Nw to "x" nails cor post 61.00' NE fo "x" nails cor post 61.00' NE							
Thereby certify that the survey work was completed and this land surveying document was prepared by me or under my direct personal surveying the laws of the state of lowa Signature: Name typed or printed Survey Signature: Name typed or printed Survey Survey	Cor A 36-97-14 130tb 50.05' NE fo"x" nails in con post 50.20' 3E fo"x" nails in pole 45.25' Sw to iron pin 56.75' Nw to "x" nails in brace post 49.25' Nw to "x" nails cor post 61.35' Nw to "x" nails cor post 61.00' NE to "x" nails cor post 49.80' fag in power pole So. 140.80' fag in power pole So. Corners Section Twp Range N/4 Cor. / 96 /4 Signature: Sign			ble physical ob	jects, relevant mo	numents and pl	nysical condition	s that will
Cor A 140 the state of lows So. 05' NE fo"x" nails in con post So. 20' 3E fo"x" nails in pole 45. 25' sw fo iron pin 56.75' Nw fo "x" nails in brace post 49.25' Nw fo "x" nails con post 61.35' Nw fo "x" nails con post 61.00' NE	Thereby certify that the survey work was completed and this land surveying document was prepared by me or under my direct personal supervision and that i am a duly licensed land surveyor under the laws of the state of lowa The state of lowa My license renewal date is December 31, 2000 So. 25' NE fo'' X'' nails in post for post in	2.00.0.0.0.0.0.0.0.0.0.0.0.0.0.0.0.0.0.				Cor	A 36-	
Thereby certify that the survey work was completed and this land surveying document was prepared by me or under my direct personal supervision and that I am a duly licensed land surveyor under the laws of the state of lowa Signature: Name typed or printed	Thereby certify that the survey work was completed and this land surveying document was prepared by me or under my direct personal supervision and that I am a duly licensed land surveyor under the laws of the state of lowa Signature: Name typed or printed Soc. 20' SE to "X" nails in pole 49.25' Now to iron pin Gl.35' Now to "X" nails cor post Gl.35' Now to "X" nails in brace post Gl.35' Now to "X" nails cor post Gl.35' Now to "X" nails in brace post Gl.35' Now to "X" nails in brace post Gl.35' Now to "X" nails in brace post Gl.35' Now to "X" nails cor post Gl.35' Now to "X" nails cor post Gl.35' Now to "X" nails in brace post Gl.35' Now to "X" nails in brace post Gl.35' Now to "X" nails cor post Gl.35' Now to "X" nails in brace post Gl.36' Now to "X" nails cor post Gl.36' Now to "X" nails cor post Gl.36' Now to "X" nails in brace post Gl.36' Now to "X" nails cor post Gl.36' Now to "X" nails in brace post	<u> </u>						
Thereby certify that the survey work was completed and this land surveying document was prepared by me or under my direct personal supervision and that I am a duly licensed land surveyor under the laws of the state of lowa Signature: Name typed or printed Signature: Name typed or printed Ny license renewal date is December 31, 2000 Ny license renewal date is December 31, 2000 Ny license renewal date is December 31, 2000	Thereby certify that the survey work was completed and this land surveying document was prepared by me or under my direct personal supervision and that I am a duly licensed land surveyor under the laws of the state of lowa Signature: Name typed or printed Soc. 20' SE to "X" nails in pole 49.25' Now to iron pin Gl.35' Now to "X" nails cor post Gl.35' Now to "X" nails in brace post Gl.35' Now to "X" nails cor post Gl.35' Now to "X" nails in brace post Gl.35' Now to "X" nails in brace post Gl.35' Now to "X" nails in brace post Gl.35' Now to "X" nails cor post Gl.35' Now to "X" nails cor post Gl.35' Now to "X" nails in brace post Gl.35' Now to "X" nails in brace post Gl.35' Now to "X" nails cor post Gl.35' Now to "X" nails in brace post Gl.36' Now to "X" nails cor post Gl.36' Now to "X" nails cor post Gl.36' Now to "X" nails in brace post Gl.36' Now to "X" nails cor post Gl.36' Now to "X" nails in brace post	Cor 17	4 1 1	/30 <u>#</u>				
Thereby certify that the survey work was completed and this land surveying document was prepared by me or under my direct personal supervision and that i am a duly licensed land surveyor under the laws of the state of lowa Signature: Name typed or printed Signature: Name typed or printed Signature: Name typed or printed My license renewal date is December 31, 2000 My license renewal date is December 31, 2000	Thereby certify that the survey work was completed and this land surveying document was prepared by me or under my direct personal supervision and that i am a duly licensed land surveyor under the laws of the state of lowa Signature: Name typed or printed My license renewal date is December 31, 2000 Next. " nails cor. post 49.80" has in power pole. So. List Comers to be indexed Corners Section Twp Range N/4 cor. / 96 // Signature: Neme typed or printed My license renewal date is December 31, 2000 My license renewal date is December 31, 2000	عدد عاد						
Thereby certify that the survey work was completed and this land surveying document was prepared by me or under my direct personal supervision and that i am a duly licensed land surveyor under the laws of the state of lowa Signature: Name typed or printed	Thereby certify that the survey work was completed and this land surveying document was prepared by me or under my direct personal supervision and that i am a duly licensed land surveyor under the laws of the state of lowa Signature: Name typed or printed My license renewal date is December 31, 2000 Next. " nails cor. post 49.80" has in power pole. So. List Comers to be indexed Corners Section Twp Range N/4 cor. / 96 // Signature: Neme typed or printed My license renewal date is December 31, 2000 My license renewal date is December 31, 2000							
Thereby certify that the survey work was completed and this land surveying document was prepared by me or under my direct personal supervision and that i am a duly licensed land surveyor under the laws of the state of lowa Signature: Name typed or printed Signature: Name typed or printed Signature: Name typed or printed My license renewal date is December 31, 2000 My license renewal date is December 31, 2000	Thereby certify that the survey work was completed and this land surveying document was prepared by me or under my direct personal supervision and that i am a duly licensed land surveyor under the laws of the state of lowa Signature: Name typed or printed My license renewal date is December 31, 2000 Next. " nails cor. post 49.80" has in power pole. So. List Comers to be indexed Corners Section Twp Range N/4 cor. / 96 // Signature: Neme typed or printed My license renewal date is December 31, 2000 My license renewal date is December 31, 2000	_ -	00	50.05' N	€ to"x" n	ails in con	post	
Control of the survey work was completed and this land surveying document was prepared by me or under my direct personal supervision and that i am a duly licensed land surveyor under the laws of the state of lowa Signature: Name typed or printed Signature:	Thereby certify that the survey work was completed and this land surveying document was prepared by me or under my direct personal supervision and that i am a duly licensed land surveyor under the laws of the state of lowa Signature: Name typed or printed My license renewal date is December 31, 2000 Note that the survey work was completed and surveying document was prepared by me or under my direct personal supervision and that i am a duly licensed land surveyor under the laws of the state of lowa Signature: Name typed or printed My license renewal date is December 31, 2000	•	65	20, 20° 3'	ピールリンパノ	Touls in D	0/0	٨
Thereby certify that the survey work was completed and this land surveying document was prepared by me or under my direct personal supervision and that i am a duly licensed land surveyor under the laws of the state of lowa Name typed or printed Signature: Name typed or printed	Thereby certify that the survey work was completed and this land surveying document was prepared by me or under my direct personal supervision and that i am a duly licensed land surveyor under the laws of the state of lowa Signature: Name typed or printed My license renewal date is December 31, 2000 Note that the survey work was completed and surveying document was prepared by me or under my direct personal supervision and that i am a duly licensed land surveyor under the laws of the state of lowa Signature: Name typed or printed My license renewal date is December 31, 2000		186	56.75	No to "X	pin nails in	brace pos	s+ /\
I hereby certify that the survey work was completed and this land surveying document was prepared by me or under my direct personal supervision and that I am a duly licensed land surveyor under the laws of the state of lowa Signature: Name typed or printed	I hereby certify that the survey work was completed and this land surveying document was prepared by me or under my direct personal supervision and that i am a duly licensed land surveyor under the laws of the state of lowa Signature: Name typed or printed Number of the state of lowa My license renewal date is December 31, 2000 Regino. 140 ** 140 ** 140 ** 140 ** 141 ** 141 ** 142 ** 144 ** 150 ** 150 ** 160 **		1 1 7 1	- 49,25'	NW to Ir	on pin	·	Y
I hereby certify that the survey work was completed and this land surveying document was prepared by me or under my direct personal supervision and that i am a duly licensed land surveyor under the laws of the state of lowa Signature: Name typed or printed Name typed or printed My license renewal date is December 31, 2000 My license renewal date is December 31, 2000	Thereby certify that the survey work was completed and this land surveying document was prepared by me or under my direct personal supervision and that I am a duly licensed land surveyor under the laws of the state of lowa Signature: Name typed or printed Name typed or printed My license renewal date is December 31, 2000 My license renewal date is December 31, 2000		8					1
I hereby certify that the survey work was completed and this land surveying document was prepared by me or under my direct personal supervision and that i am a duly licensed land surveyor under the laws of the state of lowa Signature: Name typed or printed Name typed or printed My license renewal date is December 31, 2000 My license renewal date is December 31, 2000	Thereby certify that the survey work was completed and this land surveying document was prepared by me or under my direct personal supervision and that I am a duly licensed land surveyor under the laws of the state of lowa Signature: Name typed or printed Name typed or printed My license renewal date is December 31, 2000 My license renewal date is December 31, 2000		10			, .	4	, N
I hereby certify that the survey work was completed and this land surveying document was prepared by me or under my direct personal supervision and that i am a duly licensed land surveyor under the laws of the state of lowa Signature: Name typed or printed Name typed or printed My license renewal date is December 31, 2000 Application of the survey work was completed and this land surveying document was prepared by me or under my direct personal supervision and that i am a duly licensed land surveyor under the laws of the state of lowa Number 14 Cor. 1 96 14 Signature: Name typed or printed My license renewal date is December 31, 2000	Thereby certify that the survey work was completed and this land surveying document was prepared by me or under my direct personal supervision and that i am a duly licensed land surveyor under the laws of the state of lowa Signature: Name typed or printed My license renewal date is December 31, 2000 April 200 Fee No. 2018 My license renewal date is December 31, 2000				61.35' NU	J 70 ^K"/	iails Corp	teo
I hereby certify that the survey work was completed and this land surveying document was prepared by me or under my direct personal supervision and that i am a duly licensed land surveyor under the laws of the state of lowa Signature: Name typed or printed My license renewal date is December 31, 2000 List Comers to be Indexed Corners Section Twp Range N//4 CoR. / 96 //4 5//4 CoR. / 96 //4 My license renewal date is December 31, 2000	I hereby certify that the survey work was completed and this land surveying document was prepared by me or under my direct personal supervision and that i am a duly licensed land surveyor under the laws of the state of lowa Signature: Name typed or printed Date: 6/21/00 Reg No. 2018 My license renewal date is December 31, 2000							
I hereby certify that the survey work was completed and this land surveying document was prepared by me or under my direct personal supervision and that i am a duly licensed land surveyor under the laws of the state of lowa Signature: Name typed or printed My license renewal date is December 31, 2000	I hereby certify that the survey work was completed and this land surveying document was prepared by me or under my direct personal supervision and that i am a duly licensed land surveyor under the laws of the state of lowa Signature: Name typed or printed Number type	A 14	40th 1	,	Thou ta	iv boma	th bold so	s. []
I hereby certify that the survey work was completed and this land surveying document was prepared by me or under my direct personal supervision and that I am a duly licensed land surveyor under the laws of the state of lowa Signature: Name typed or printed Date: B/21/0D Reg No. 90/8 My license renewal date is December 31, 2000	I hereby certify that the survey work was completed and this land surveying document was prepared by me or under my direct personal supervision and that I am a duly licensed land surveyor under the laws of the state of lowa Signature: Name typed or printed Date: 8/21/00 Reg*No. 90/8 My license renewal date is December 31, 2000							M
and this land surveying document was prepared by me or under my direct personal supervision and that i am a duly licensed land surveyor under the laws of the state of lowa Signature: Name typed or printed Number 1	and this land surveying document was prepared by me or under my direct personal supervision and that i am a duly licensed land surveyor under the laws of the state of lowa Signature: Name typed or printed Number of the state of lowa Number of the state of lowa Number of the state of lowa Signature: Name typed or printed Number of the state of lowa Number of the state of lowa Signature: Name typed or printed Number of the state of lowa Nu	7-76-79 —						
and this land surveying document was prepared by me or under my direct personal supervision and that i am a duly licensed land surveyor under the laws of the state of lowa Signature: Name typed or printed Signature: Date: 6/21/00 Reg No. 20/8 My license renewal date is December 31, 2000	and this land surveying document was prepared by me or under my direct personal supervision and that i am a duly licensed land surveyor under the laws of the state of lowa Signature: Name typed or printed Number of the state of lowa Number of the state of lowa Number of the state of lowa Signature: Name typed or printed Number of the state of lowa Number of the state of lowa Signature: Name typed or printed Number of the state of lowa Nu							
me or under my direct personal supervision and that i am a duly licensed land surveyor under the laws of the state of lowa Signature: Name typed or printed Date: B/21/0D Reg INo. 20/8 My license renewal data is December 31, 2000	me or under my direct personal supervision and that i am a duly licensed land surveyor under the laws of the state of lowa Signature: Name typed or printed Date: 8/21/00 Reg No. 20/8 My license renewal date is December 31, 2000	I hereby certify tha	t the survey work was c	ompleted	l	ist Comers to	be Indexed	
am a duly licensed land surveyor under the laws of the state of lowa Signature: Name typed or printed STENE BUSSE Date: 6/21/00 Reg INo. 20/8 My license renewal date is December 31, 2000	am a duly licensed land surveyor under the laws of the state of lowa Signature: Name typed or printed Date: 8/21/00 Reg No. 20/8 My license renewal date is December 31, 2000	and this land surve	ying document was pre	pared by			•	
Signature: Name typed or printed Signat	Signature: Name typed or printed Signat	am a duly licensed	land surveyor under the	e laws of		/		
Name typed or printed STOKE BUSSE Date: 8/21/00 Reg No. 90/8 My license renewal date is December 31, 2000	Name typed or printed SUSSE Date: 8/21/00 Reg INo. 20/8 My license renewal date is December 31, 2000	the state of lowa	/ Jumm may		5/4 (OR.	/	76	, ,
Date: 8/21/02 Reg No. 2018 My license renewal date is December 31, 2000	Date: 8/21/00 Reg No. 2018 My license renewal date is December 31, 2000	Signature:	Texus Dur	ne				
My license renewal date is December 31, 2000	My license renewal date is December 31, 2000	10/10/1	76 5	.c ≥e				
		Date: 8/21/0	201 Reg. No. 201	8				
SEAL	SEAL	My license renewa	il date is December 31,	2000				
		SEAL	A Training		ļ			
			•					