Instrument #: 2920-1125
06/08/2020 02:38:28 PM Total Pages: 1
SCC SECTION CORREC CERTIFICATES
Recording Fee: \$ 7.00
Shirley Troyna, Recorder, Chickasaw County Iowa

Prepared by & Return to: Herold - Reicks Surveying, 10 East Main Street, New Hampton, 19 50559, Ph. 64-394-2725

United States Public Land Survey Corner Certificate

Land Survey Monument situated in

Section 8, Township 96 North, Range 14 West of the Fifth Principal Meridian, Chickasaw County, Iowa.

On file in Document #2009-1100 in the County Recorder's office.

This certificate is being prepared in compliance with Iowa Code Chapter 355.11 because:

∫1.) & 2.)⊠


- ☐ There is no certificate on file for this corner.
 - There are no longer three valid ties of record.
 - There are changes to reference ties of record.
- There is change of monumentation of record.
- To clarify description of record monument (ties).

Monument Description and Remarks:

- 1.) SE Corner SW 1/4-NE 1/4 Section 8-96-14: Fd. 1/2"Ø Rebar with information obtained from the previously recorded Section Corner Certificate.
- 2.) SE Corner SW 1/4-SE 1/4 Section 8-96-14; Fd. 5/8"Ø Iron Pin with information obtained from the previously recorded Section Corner Certificate,

Plan View

(Show a minimum of three reference ties to durable physical objects, relevant monuments and physical conditions that will enable recovery of the corner.)

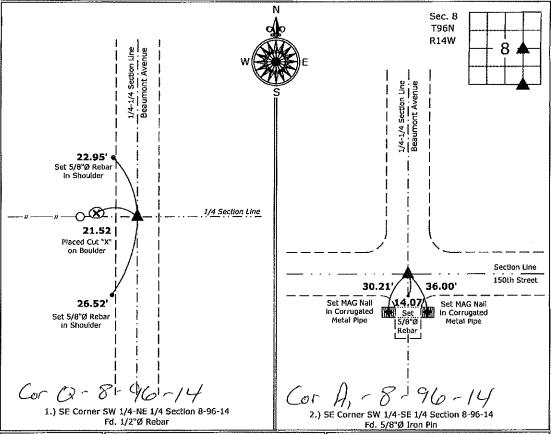

PAUL R. HEROLD TO 15525

I hereby certify that this land surveying document was prepared and the related survey work was performed by me or under my direct personal supervision and that I am a duly licensed Land Surveyor under the laws of the State of Iowa.

Paul R. Herold Date:

License number 15525

My license renewal date is December 31, 2020. Sheets covered by this seal: Individual sheet only

List Corner to be Indexed					
Corner	Section	Twp.	Range		
NE-NW-SE	8	96	14		
SE-SW-SE	8	96	14		

Project Number: 2020-052 FB: Chickasaw 10 , Pg. 47 ile: S.\. Projects - NHO\County Control Systems - NHO\CHICKASAW\CHICK-9\CHICK-9 - 2020.dwg, 5/29/2020 4:46:11

Chickasaw Co. Recorder Cindy Messersmith Fee Book 2009-1100 05/29/2009 61210PM SCC SEC COR CERT Book: Page: \$7.00 # Pages: 1

Herold - Reicks Surveying, 25 1/2 East Main Street, Suite 204, New Hampton, IA 50659, Ph. 64-394-2725 UNITED STATES PUBLIC LAND SURVEY CORNER CERTIFICATE Land Survey Monuments situated in Section 8, Township 96 North, Range 14 West of the Fifth Principal Meridian, Chickesaw County, Iowa. Previously not recorded in the County Recorder's office. 1.) & 2.) 🔟 There is no certificate on file for this corner. There are no longer three valid ties of record. This certificate is being prepared in compliance There are changes to reference ties of record. with Iowa Code Chapter 355.11 because: There is change of monumentation of record. □ To clarify description of record monument (ties). Monument Description and Remarks: 1.) SE Corner SW 1/4-NE 1/4 Section 8-96-14: Fd. 1/2*Ø Rebar from information obtained from the County Engineer's Office, and on a survey and plat made by Harlan K. Schuck, recorded January 31, 2002, Document #2002-033 2.) SE Corner SW 1/4-SE 1/4 Section 8-96-14: Fd. 5/8"Ø Iron Pin from Information obtained from the County Engineer's Office, and on a survey and plat made by Harlan K. Schuck, recorded January 31, 2002, Document #2002-033 PLAN - VIEW (Show a minimum of three reference ties to durable physical objects, relevant monuments and physical conditions that will enable recovery of the corner.) Sec. 8 **T96N** Q **R14W** Lower Deerfield Twp. Set 1/2*Ø Rebar (38.41 O 29,61 Set 1/2"Ø Rebar O East side of 24" Section Line Rock 33.79 150th Street 30.15 36.00 Set 1/2"Ø Rebar East side of Set MAG Nail top end CMP Culvert Telephone Sign Set MAG Nail S:_Projects\2009\2009-052\dwg\2009-052.dwg, 5/22/2009 03:22 top end CMP Culvert Set 1/2 Ø Rebar cor. Al car. Q 2.) SE Corner SW 1/4-SE 1/4 Section 8-96-14 1.) SE Corner SW 1/4-NE 1/4 Section 8-96-14 Fd. 1/2"Ø Rebar Fd. 5/8"Ø Iron Pin I hereby certify that this land surveying document was prepared and the related survey work was performed by me or under my direct personal supervision and that I am a duly licensed Land Surveyor under the laws of the State of Iowa. Paul R. Herold 5-22-09 HEROLD

License number 15525

My license renewal date is December 31, 2010. Sheets covered by this seal: Individual sheet only

List Corners to be Indexed					
Corners	Section	Twp.	Range		
NE-NW-SE	8	96	14		
SE-SW-SE	8	96	14		

Project Number: 2009-052 FB: Chickasaw County 2, Pgs. 12-14