Chickasaw Co. Recorder Cindy Messersmith Fee Book 2012-2141 10/26/2012 @0429PM SEC COR CERT Book: Page: \$7.00 # Pages: 1

Prepared by & Return to: Herold - Reicks Surveying, 10 East Main Street, New Hempton, 19 50659, Ph. 54-354-2725

UNITED STATES PUBLIC LAND SURVEY CORNER CERTIFICATE

Land Survey Monuments situated in Section 34, Township 96 North, Range 12 West of the Fifth Principal Meridian, Chickasaw County, Iowa. 1.) Not previously recorded in the County Recorder's office.

2.) Previously recorded in Bk. 159, Pg. 70, In the County Recorder's office.

This certificate is being prepared in compliance with Iowa Code Chapter 355.11 because:

{


- 1 ☒ There is no certificate on file for this corner.
 2 ☒ There are no longer three valid ties of record.
- There are changes to reference ties of record.
- ☐ There is change of monumentation of record.
 ☐ To clarify description of record monument (ties).

Monument Description and Remarks:

- 1.) West 1/4 Corner: Found 6"x9" Blue Granite Stone from information obtained from County Engineers Office. Set new ties to update the corner. Set 5/8"Ø Rebar w/2"Ø Alum. Cap 0.30' Northeast as an Accessory.
- 2.) Northeast 1/4 Corner: Found 1/2"Ø Rebar w/YPC PLS 11442 from information obtained from a previous Section Corner Certificate, set new ties to update the corner.

PLAN - VIEW

(Show a minimum of three reference ties to durable physical objects, relevant monuments and physical conditions that will enable recovery of the corner.)

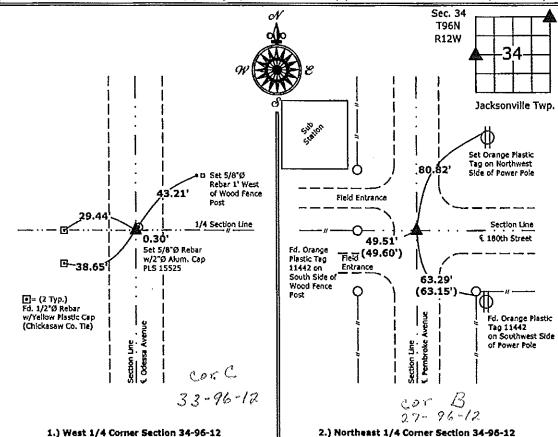



I hereby certify that this land surveying document was prepared and the related survey work was performed by me or under my direct personal supervision and that I am a duly licensed Land Surveyor under the laws of the State of Iowa,

Paul R. Herold Date:

License number 15525

Found 6"x9" Blue Granite Stone

My license renewal date is December 31, 2012. Sheets covered by this seal: Individual sheet only

List Corners to be Indexed				
Comers	Section	Twp.	Range	
W 1/4	34	96	12	
NE	34	96	12	

Found 1/2"Ø Rebar w/YPC PLS 11442

pects\2012\2012-183\2012-183.dwg, 10/25/2012

S:\ C:S

Project Number: 2012-183 F8: Chickasaw County 4, Pgs. 63-64

	S TRANSFER FEE . \$ O'CLOCA . BOOK 159 DE	95 AT 8:30 SEELLE ROOM, RECORDER EELING N. ROSS PAGE 70 BY Description	
	il e	D SURVEY CORNER CERTIFICATE	
		OF 27	
	Land Survey Monuments situated in Sec Range 12 W, of the Fifth Prin County, Iowa. Previously recorded in County Recorders Office.	cipal Meridian, Chickasaw	
	•	, the evidence and detailed procedures used i	
	Monument Description and Remarks:	nis certificate is prepared in accordance with	
		this case no previous certificate has been filed	
		ngineer's reference ties we found this corner but	
		bar 2' deep at the centerline intersection of	
		erence ties, but all ties previously taken appear	
	to have been lost. We took new ties to the		
	Sec. 26-96-12 and set a ½" bar with cap RLS i	- VIEW	
	(Show a minimum of three reference ties to ophysical conditions that will enable recovery	durable physical objects, relevant monuments any of the corner.)	
	S.W. Cor. Fd 3/4"Bar 2'deep, over top	Set 1/2" bar W/cap	
Section 27-96-17			
Section 27-96-19 As referred to in Engr. Tie Book	1	Top & Steel Con Post Filled w/concrete	
Engr. The Book		The same of the control of the	
O			
		10 Delle	
	# 49.60 X	<u>& Co. Rd.</u>	
	"Noilw/cap S. side Cor. Post	le.	
	Post	fire the state of	
		ıt	
	Cor B	Nail W/Cap E. side Power Pole	
	27-96-12	Side Fower Fole	
	I hereby certify that the survey work was completed and this		
	supervision and that I am a duly registered land surveyor	List Corners to be Indexed Corners Section Twp, Range,	
	under the laws of the State of lowa. Signature:	S.W. Cor. 26. 96 12	
	Lindsay Erdman, P.E. & L.S.	C. R 50 8/ 15	
	Date: Reg. No11442	Cor B-27-96-12	
	Hy license will be renewed <u>January 1, 1997.</u> SEAL	Lie Por	
	SAY EROMANA	and with	
	REGISTERE VI	The state of the s	
	11442		
	3	Cor B-27-96-12 Plant in the foot 10/10/05	
	A LAND SURVEY		
	Manufacture.		
	159 720		