Chickasaw Co. Becorder
Cindy Messersmith
Fee Book 2015-0186
02/19/2015 @0954AM
SCC. SEC COR CERT
BOOK. Page: \$7.00 # Pages: 1

Prepared by & Return to: Herold - Reicks Surveying, 10 East Main Street, New Hampton, 19 50659, Ph. 644-394-2925

UNITED STATES PUBLIC LAND SURVEY CORNER CERTIFICATE

Land Survey Monuments situated in Section 18, Township 95 North, Range 12 West of the Fifth Principal Meridian, Chickasaw County, Iowa. 1.) Previously recorded in Bk. 148, Pg. 140 in the County Recorder's office. 2.) Previously recorded in Bk. 151, Pg. 184 in the County Recorder's office.

This certificate is being prepared in compliance with Iowa Code Chapter 355.11 because:

Monument Description and Remarks:

se:

☐ There is no certificate on file for this corner.

2 ☑ There are no longer three valid ties of record.

¹ ☒ There are changes to reference ties of record.
 ☐ There is change of monumentation of record.


☐ To clarify description of record monument (ties).

- 1.) North 1/4 Corner: Fd. 1/2 rebar w/Orange Plastic Cap PLS 7060 with information obtained from previous Section Corner Certificate (Bk. 148, Pg. 140).
- 2.) South 1/4 Corner: Fd. 3/4"Ø Rebar with information obtained from previous Section Corner Certificate (Bk. 151, Pg. 184).

Note: This Section Corner Certificate is being prepared to update the older certificates in order to add graphical detail.

PLAN - VIEW

(Show a minimum of three reference ties to durable physical objects, relevant monuments and physical conditions that will enable recovery of the corner.)

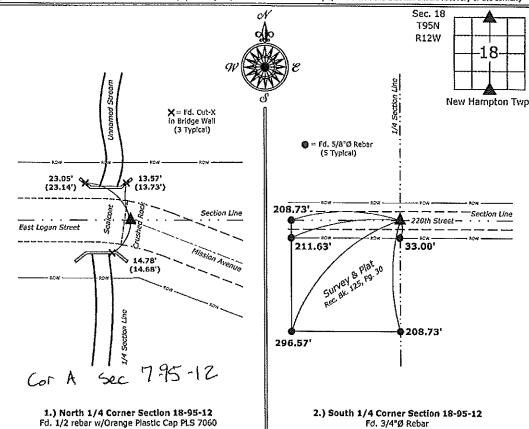



I hereby certify that this land surveying document was prepared and the related survey work was performed by me or under my direct personal supervision and that I am a duly licensed Land Surveyor under the laws of the State of Iowa.

Paul R. Herold Date

License number 15525

My license renewal date is December 31, 2016. Sheets covered by this seal: Individual sheet only

List Corners to be Indexed				
Comers	Section	Twp.	Range	
N 1/4	18	95	12	
S 1/4	18	95	12	

Control Systems/CHICKASAW\CHICK-28 (New Hampton

Project Number: 2015-027 FB: New Hampton 2, Pgs. 28-29

UNITED STATES PUBLIC LAND SURVEY CORNER CERTIFICATE

OF

and Survey Monuments situated in Section	, Township , Range County, Iowa.
(hook page document number etc.)	
how reason for preparing this certificate, the evidence and detailed pro entation found or placed.)	
Ionument Description and Remarks: 526 S.	KETEH
•	
PLAN - VI	EW
covery of the corner.)	evant monuments and physical conditions that will enable
54 CORNER	
34 CORNET	
FOUND /RON	
BAR - X" NAILS W.	
BAR "X" NAILS W. SIDE CORNER POST	/
10. K	
Fo. 34 BAR	
10.14 DAR	SE CORNER
₁₈ 37	/ SE CORNER
" " <u>.</u>	
"X" NAILS NORTH	"X" HALLS IN FENCE CORNER PAST
SIDE POWER POLE	Post
ALSO FO. "X" ON EAST SIDE @ 49.35'	1
CAST SIDE (0 47.33	N N N N N N N N N N N N N N N N N N N
cor. A	u)
Cor. 17	Found & BAR
	4
	W. J. J. Ferral Control of the Contr
	W.
	"X" NAILS
'X" NAUS EAST ST	
EAST SI	
10WER /	<i>yee</i>
I haraby cartify that the current under	
I hereby certify that the survey work was completed and this certificate was prepared by me or under my direct personal supervision and that	List Corners to be Indexed Corners Section Twp Range
I am a duly registered land surveyor under the laws of the state of lowa.	
	V 5 4 18 95 12
Name typed or printed: L. F. ERDMAN	SE 18 95 12
Dale: <u>Z/-//- 9 }</u> Reg. No. <u>2886</u>	F -
-	-
	Placed in to 2/22/93
	I Wall in the
	1 2/2/93
SEAL	
SEAL	2/6/
SEAL	2/6/
SEAL	2/01
SEAL	2/01
SEAL	\$ 15006 Circu
	# 15006 Core
SEAL As DOCUMENT No. 01692 BECORDING FEE S. S. CO. J.	# 15006 Even 2/11/23