Chickasaw Co. Becorder Cindy Messersmith Fee Book 2000 1027AM 03/02/2010 @1027AM CCC. SEC COR CERT Page: \$9.00 Fee Book 2010-0281 # Pages: 1

rad by Harold - Rancks Surveying, 18 East Main Street, New Hampton, 19 58658, Ph. 64-394-2725 Fax. 64-394-278

UNITED STATES PUBLIC LAND SURVEY CORNER CERTIFICATE


Land Survey Monuments situated in Section 9, Township 95 North, Range 12 West of the Fifth Principal Meridian, Chickasaw County, Iowa. 1.) Previously recorded in Bk. 2001, Pg. 2814 in the County Recorder's office. 2.) Not previously recorded in the County Recorders Office.

This certificate is being prepared in compliance with Iowa Code Chapter 355.11 because:

2.)区 There is no certificate on file for this comer. There are no longer three valid ties of record. П 1.) There are changes to reference ties of record. There is change of monumentation of record. To clarify description of record monument (ties).

Monument Description and Remarks:

- 1.) Center of Section: Found T-bar 4" deep from information obtained from the previous Section Corner Certificate.
- 2.) SE Corner SW 1/4-SE 1/4: Set 5/8"Ø rebar with 2"Ø aluminum cap PLS 19211 online between and at the record distance from the SE and S 1/4 Corners per Plat of Survey made by Paul R. Herold, recorded as Document #2001-2816 on file in the Chickasaw County Recorder's office.

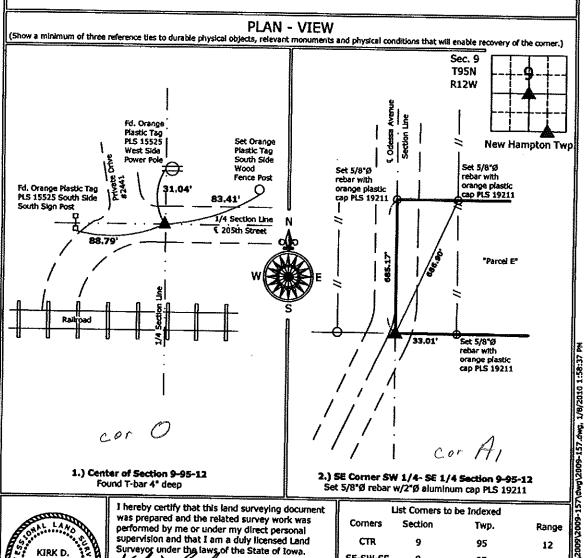



I hereby certify that this land surveying document was prepared and the related survey work was performed by me or under my direct personal supervision and that I am a duly licensed Land Surveyor under the laws of the State of Iowa. 3-2-10

eilo Kirk D. Reicks

Date:

License number 19211 My license renewal date is December 31, 2010. Sheets covered by this seal: Individual sheet only

List Corners to be Indexed					
Corners	Section	Twp.	Range		
CTR	9	95	12		
SE-SW-SE	9	95	12		
			,		

Project Number: 2009-157 FB: Chickasaw County 2, Pgs. 27-28

FILED 2001-2814 RECORDER'S OFFICE CHICKASAW COUNTY, 10WA

2001 DEC 26 AM 8 51

CINDY MESSERSMITH COUNTY RECORDER

Tekippe Engineering, P.C., 128 South Vine Street, West Union, Iowa 52175 Phone (563) 422-5131
UNITED STATES PUBLIC LAND SURVEY CORNER CERTIFICATE
OF
Land Survey Monuments situated in Section 9 , Township 95 North, Ran 12 West of the Fifth Principal Meridian, CHICKASAW County, Iow
Previously recorded in none in County Recorder's Office (book page, document number, etc.)
Show reason for preparing this certificate, the evidence and detailed procedures used in establishing the corner positions and monumentation found or placed.)
Monument Description and Remarks: Center of Section 9 T95N R12W: Found T-bar with information obtained from a Survey and Plat made by Roger Hanson recorded
the Chickasaw County Recorder's Office on October 12, 1965 in Book 91, Pages 476-4
DIAN WEW Project Number 01232.LS
PLAN - VIEW Project Number 101232.15 FB. 46 H PG. 62-63 (Show a minimum of three reference ties to durable physical objects, relevant monuments and physical conditions that will enable recovery of the corner.)
Set orange plastic tag PLS 15525 West side power pole wood cor. post South side South post Sign Set orange plastic tag PLS 15525 West side power pole wood cor. post New Hampton
205th St
existing rollroad
1 Cook Q

Center of Section 9 T95N R12W Found T-bar



I hereby certify that this land surveying document was prepared and the related survey work was performed by me or under my direct personal supervision and that I am a duly licensed land Surveyor under the laws of the State of lowa.

Paul R Herold 12-21-01
Paul R Herold Date
License number 16526

My license renewal date is December 31, 2002. Sheets covered by this sear Individual

Corners	List Corners Section	to be Indexed Twp.	Range		
Center	9	95N	12W		
External in field book 1-10-02					

County Engineer's