
## COUNTY ENGINEER'S SECTION CORNER PRESERVATION RECORD

Land survey monument located in section 3, township 94 N north, range 13 W , of the 5th p.m. Chickgsqw county, iowa previously recorded Filed 2001-1918 .

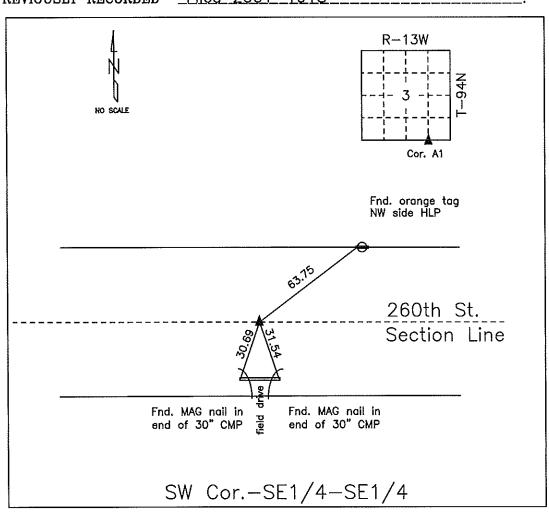

MONUMENT DESCRIPTION AND NARRATIVE Fnd 3/4" iron shaft
Previously recorded 9-6-01 by Paul Herold (PLS 15525) & is filed as 2001-1918
All ties are slope chained
I AM NOT A REGISTERED LAND SURVEYOR UNDER THE LAWS OF THE STATE OF IOWA
JIM FOSTER CHICKASAW CO. DATE: 11/4/08

## PREPARED BY ROBERT L. HOLZE HID-WEST LAND SURVEYORS, INC., P.O. BOX 1352, MASON CITY, IOWA 50402-1352, I6411-423-1451 UNITED STATES PUBLIC LAND SURVEY CORNER CERTIFICATE

0 F

Lond							Section					94N	, Rang	-
D	131				the	Fifth	Principal	Merid			CKASAN		unty, lov	
(Show	reason onuzent	for pr ation	found or	hts o	erf1f( :d <u>.</u> )	cate.	, document, muthe evidence o		c.)		·	Recorder		
$\sim$			iption RFOUND				$\overline{}$			<u>OLINO 5/8</u> SE1/4 SE1				
_							TH ALUMINU		"					
(4)_	SOUTI	WEST	CORNER	SE I	/4-SE	1/4	FOUND 1/2'	REBAR	WITH CAS	NOT LEE	GABLE			
(5)	SOUT	HEAST	CORNER	R FO	UND 5	/8° F	REBAR							
(6	) sou	THEAS	T CORNE	RN	E1/4-	SE1/4	SET P&C #	8656 D	N SPLIT					_
							PLAN	- V I	ΕW					
			three re-	feren	ce fie	s to du	rable physica	l objects	, relevoni	monuments	and phys	ical condit	ions that w	T I I V
		,									SECT	10N 3		
													z	
			Coff		Ι,	<u> </u>				Cor ()	2		94	
			Δ		WIZA						+	# 7 + - 4	<u>a'</u>	
			ব			. P&C IOT		(7)		cor B sec y	4	3 14 3 13 <sup>4</sup> W <sup>81</sup>	5 B	
			681.64		LED	SABLE		W COR.			F	(6)		
			168					/4-SE1 P&C #8			ĮΝΕ1.	E COR. /4-SE1/4	1	A
					POL.	FND.		J 394	.67	P&0 #865	is 01	P&C #865 N SPLIT, "	6	$\mathbb{A}$
		AVE.	ot			IPE		η <u>δ</u> Ε	X 20	<del>X</del>	37.1	20 ∆ B''	?	-/ \
			~ (					4 ⊠.	E	331.30		Ø4 CA		$I\Gamma$
<b></b> "	,	1 VANHOE	m					Pi₄ b	8C				i i	
FN9 X-NA	ILS	Σ×	5.59		x-	NAILS	5	, <sub>#8</sub>	656	FND. X-NAIL	_	1323 JASPER	FNO.	. N
_P.I	۲ <u>.</u>		97			P.P.	0. 0			COR. PC		X	IN P.	F21 1
		S.		160	,	I/ REE		65 F	1/2" REBAR		8	0	0	$\Lambda$
		G	· · · · · ·	> -			\$	40.		^	•	(a 4). 's		Ш
			<u> </u>	/	260	14.87	∆ A¤		25.54	$\frac{\Delta}{A^{lef3}}$ 13	325.54	_ A BOF	13	
			45	S,			77 11	- 5	26ØTH 5	STREET		 		
					)							و ع		
1	ı					MILS	(3)		(4	1)		ASTIC	(5)	_
SW C FND !					-	.թ. የ	51/4 <sup>-</sup> COI FND. 1/2 <sup>-</sup> 1		SW Č SE1/4-	DR.		Y MARKER GN POST	SÉ COF FND, 5/	
REE							W/ALUM () NOT	AP		REBAR	# 1	5525	REBAR	₹
	ŀ						LEDGABL	E.	LEDG					
l hei	reby	certi	fy that	th	e sur	vey w	orkseason.			List of	Corne	rs to be	Indexed	
сотр	leted	and	this ce	rti	flcat	e wos	grepered	59.4						
me or	r und	er my	direct	ре	rsona	i Sug	eryjsion.	X Co	ners		Section		wp. 94N	Range
						F27 0	a Surveyor		SW COR. W1/4 CC			3 3	94N	13W
មហថ្មា	r the	lows	of the	: St	ate o		· 8355		S1/4 CC			3 3	94N 94N	13W 13W
Sign	ature		<u>Hobr</u>	<u>ス</u>	2 1	4,	ا ا		SE COR.		, ,	3 3	94N 94N	13W
	,		bert L.			8.				NE1/4-SE NW1/4-SE	17 "	3	94N	13W
Date	:	16 3	<u> 2003</u>	R	eg. N	o. È	656 SUN	# 3 # E		pm, 1 1	_	_		
	٠,	. '			_					Filed	2-	20-03		

My registration reneval date is December 31, 2003.

Section 3-94-13 As referred to in Engr. Tic Book

FILED 2001-1918 RECORDER'S OFFICE CHICKASAW COUNTY, 10WA

2001 SEP 6 AM 9 27

CINDY MESSERSMITH

	COUNTY RECO	PRDER	
The second second was the second was the second was the second se	Union Iowa 5217	6 Phone (563)	422-5131
TeKIPPE ENGINEERING, P.C., 128 South Vine Street, West UNITED STATES PUBLIC LAND SUF	VEV CORNE		
		IIV OLIVATI IV	
OF	3	. a4 x	Tauth Dongo
Land Survey Monuments situated in Section	Townsh	ip N	orth, Range
	, CHICKAN	SAW C	ounty, Iowa.
Previously recorded in (1) none (2) Book 153,	, e.c.,		
(Show reason for preparing this certificate, the evidence an the corner positions and monumentation found or placed.)			
Monument Description and Remarks: (1) NW Corr	er NE 1/4-NE	1/4 Section	10 194N R13
Found 9/4"d from shaft with information obtains	ed from a sur	vey and Flat	made by
Harold H. Blessing recorded in the Chickasaw C	ounty Recorde	rs Unice on	April 16, 1979
in Deed Book 119, Page 362-365.	- C Mon	umont was Tr	issing. Set
(2) S 1/4 Corner Section 10 T94N R13W: Previous	na distances f	from found co	oncrete
1/2" o rebar w/2" o aluminum cap PIS 15525 usi monuments noted on the previous Section Corn	ar Cartificate	recorded in	the
Chickasaw County Recdorder's Office in Deed Bo	ok 153 Page	419.	<del></del>
			roject Number 01182.IS
PLAN - V	IEW	F	TA 461 PG. 31-34
(Show a minimum of three reference ties to durable physical	cal objects, releva	nt monuments a	and physical
conditions that will enable recovery of the corner.)			
		Sec. 10	10
1		T94N R13W	
			-+- -+-
Set orange plastic tag PLS 15525			
NW side power pole			Richland Twp.
			0.65 Found conc.
cis/		9	
63.00			mon.
260th St.	5.9	′± <u>↓</u> ∡ <u> </u>	ection Line
Section Line	———	<u>√</u> -~_€	Towa Hwy. 346
Placed MAG nail	3		100
end of 30" CMP   end of 30" CMP	,g1,fd		105.96.
end of 30° CMP 기  end of 30° CMP culvert 기를 culvert	7		
1	r Found	.4	Found 🖭
Λ	mon.	or A	mon.
Cor. AI			
3-94-13			
		- 40 70 41 0471	,
NW Corner NE 1/4 - NE 1/4 Section 10 T94N R13W	S 1/4 Corner Sect	ar w/2"ø aluminur	n cao PLS 15525
Found 3/4*ø iron shaft	300 1/2 9 100	1/	
	List (	Corners to be In	dexed
I hereby certify that this land surveying document was prepared and the related survey work was	Corners S	ection Twp.	Range
performed by me or under my direct personal		40 041	13W
Surveyor under the laws of the State of lows.	NW-NE-NE	10 94N	1011

S 1/4

10

Filed 9-10-01

94N

-Paux R. Herass 9-5-01

My license renewal data is December Si, 2002. Sheets covered by this seal: Individual

Paul R. Herold License number 16525 13W