
COUNTY ENGINEER'S SECTION CORNER PRESERVATION RECORD

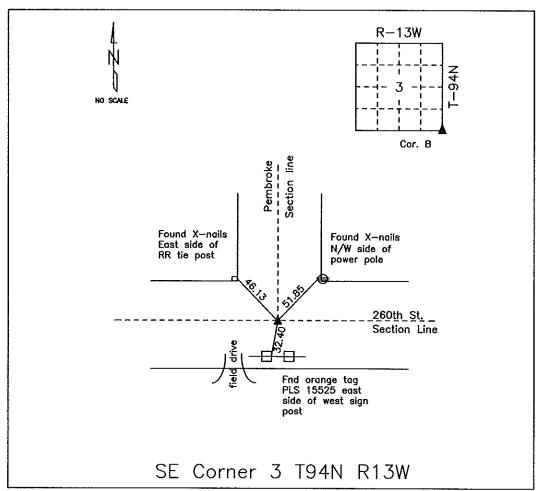

| MONUMENT DESCRIPTION AND NARRATIVE Found 5/8" iron pin |
|---|
| |
| Previously recorded by Paul Herold (PLS 15525) in Book 2003, Page 0554 as the N/E corner of section |
| 10, T94N, R13W |
| All ties are slope chained |
| I AM NOT A REGISTERED LAND SURVEYOR UNDER THE LAWS OF THE STATE OF IOWA |
| JIM FOSTER CHICKASAW CO. DATE: 11/04/08 |
| |

Section 3-94-13 As referred to in Engr. Tie Book

FILED 2003-0554 RECORDER'S OFFICE CHICKASAW COUNTY, IOWA

2003 FEB 24 AM 9 47

CINDY MESSERSMITH COUNTY RECORDER

| TeKIPPE ENGI | NEERING, P.C., 128 South Vine S | treet, West | t Union, Iowa | 52175 F | hone (563) 42 | 2-5131 | | | |
|--|--|--------------------|--------------------------|---|----------------------------------|----------------|--|--|--|
| UNITE | D STATES PUBLIC LA | | RVEY CO | RNER C | ERTIFICA' | ΓE | | | |
| I and Survey h | fonuments situated in Se | OF ction | 10 3 To | wnship | 94 Nort | h, Range | | | |
| 13 y | lest of the Fifth Principal | Meridia | n, CH | | Cour | | | | |
| Previously rec | orded in Book 200 | 1, Page | 1916 | | ty Recorder | | | | |
| (Show reason for | preparing this certificate, the | evidence a | nd detailed p | rocedures u | ised in establi | shing | | | |
| | scription and Remarks: N | | | T94N R1 | SW: Found 6 | 5/8"ø | | | |
| iron pin with | information obtained from | n the Cl | hickasaw C | ounty Eng | gineer's Offi | ce in the | | | |
| Field Book for | Richland Township Corne | er Ties, S | Section 4, | Corner B. | | | | | |
| NE Corner Sec | ction 10 T94N R13W: Found | 1 5/8"ø | iron pin w | ith inforn | nation obtai | ned from | | | |
| | County Engineer's Office | in the | Fleid Book | for kien | and lownsh | nb corner | | | |
| Ties, Section | s, corner b. rrective Corner Certificate | is bein | g filed to | correct t | he title at | the | | | |
| | plan view diagram (the) | | | | | | | | |
| PLAN — VIEW Project Number Office Lise FR. 481 PG. 31-34 (Show a minimum of three reference ties to durable physical objects, relevant monuments and physical | | | | | | | | | |
| (Show a minimum conditions that was a second conditions that was a second conditions that was a second conditions as a second condition conditions as a second condition conditions as a second condition condition condition condition condition condition conditions as a second condition | m of three reference ties to du will enable recovery of the corn | rable phys er.) | ical objects, | relevant mo | numents and | рпувісаі | | | |
| | | | | | | ; ^ | | | |
| | | | | | Sec. 10 - | 1 4 684 | | | |
| | | | | | R13W | 140 | | | |
| | | | | ' | | ţ- - ţ- | | | |
| Found X-nail SW side | s [] | | | 1 | Piol | hland Twp. | | | |
| power pole | | | Found X-nails | Ave. | , Kie | mana 1mp. | | | |
| ==\frac{-\frac{1}{2}}{2} | cop TeKippe | Eng, | East side RR tie post | Ave | | = | | | |
| 55.19 | Control Point | | 0.46 | Jasper , | 1 84 50 | nd X-nails | | | |
| | | - T | ** | ζ j šlš | S. NW | side | | | |
| | 260th St | | | XL | /\ pow | er pole | | | |
| Placed MAG | Section Li | ne | | - \ <i> </i> / | | | | | |
| mail in end | 77 33,78 | | 260th St Section L | | | | | | |
| of 36"¢ CMP culvert | | • | Section L | line | | | | | |
| (2-typical) // | . ' ej e ' . 1 > L⊆ | | | 32.4 | 12' | | | | |
| " | hoe Ave. | | Cor. B | 188 | Set orange pi tag PLS 1552 | lostic s | | | |
| cor B | | ļļ. | | ₩ | - East side of | West post | | | |
| 4-94-13 | | 3 | 3-94-13 | ار.ا ا 5 ا | sign | | | | |
| 1 17 | | | | - • | | | | | |
| | | lj. | | | | | | | |
| NW | Corner Section 10 T94N R13W | | NΕ | | on 10 T94N R13 | W | | | |
| | Found 5/8"ø iron pin | | | Found 5/8° | Ø Iron pin | | | | |
| | * * · · · * · · · · · · · · · · · · · · | | 1 | ist Corners | to be Indexed | | | | |
| THE PARTY OF THE P | I hereby certify that this land surveyly was prepared and the related survey v | mork was | Corners | Section | Twp. | Range | | | |
| | performed by me or under my direct supervision and that I am a duly licen Surveyor under the laws of the State | sed Land | NE | 10 | 94N | 13W | | | |
| PAUL R. | Periodor, duder ma tras or me proce | | **** | 10 | V 311 | | | | |
| HEROLD 15525 | 55-5 Borst Fanot | -03 | NW . | , 10 | 94N | 13W | | | |
| ************************************** | Paul R. Herold License number 16526 | nare | Driginal File 9 | | Residens | 3 | | | |
| WHITE THE | My license renewal date is December 3 Sheets covered by this seal: Individue | | File 7 | - <i>/ 0 ^ 0 </i> iers\Sec. 10\10-9 | 94N Re-155 u 6 94-13ae.dwg | -28-03 | | | |
| | | | V. Decrioit coll | 1011U-0 | Indornañ | | | | |

County Erginicis

PREPARED BY ROBERT L. HOLZE HID-WEST LAND SURVEYORS, INC., P.O. BOX 1352, MASON CITY, IOWA 50402-1352, I6411-423-1451 UNITED STATES PUBLIC LAND SURVEY CORNER CERTIFICATE

0 F

| Lond | | | | | | | Section | | | | | 94N | , Rang | - |
|--|-------------------|-----------------|-------------|-------|-------------------------|--------------|--|------------------|--------------------|------------------------------|----------|---|-------------------|--------------|
| D | 13W | | | | the | Fifth | Principal | Merid | | | CKASAN | | unty, lov | |
| (Show | reason onuzent | for pr ation | found or | hts o | erf1f(:d <u>.</u>) | cate. | , document, muthe evidence o | | c.) | | · | Recorder | | |
| Monument Description and Remarks: (1) SOUTHWEST CORNER FOUND 5/8° REBAR (2) WI/4 CORNER FOUND P&C NOT LEDGABLE (7) SW COR. NWI/4-SE1/4 SET P&C #8656 | | | | | | | | | | | | | | |
| (3) S1/4 CORNER FOUD 1/2: REBAR WITH ALLMINUM CAP NOT LEDGABLE | | | | | | | | | | | | | | |
| (4) SOUTHWEST CORNER SE1/4-SE1/4 FOUND 1/2' REBAR WITH CAP NOT LEDGABLE | | | | | | | | | | | | | | |
| (5) SOUTHEAST CORNER FOUND 5/8" REBAR | | | | | | | | | | | | | | |
| (6) SOUTHEAST CORNER NEI/4-SEI/4 SET P&C #8656 ON SPLIT | | | | | | | | | | | | | | |
| | | | | | | | PLAN | - V I | ΕW | | | | | |
| | | | three re- | feren | ce fie | s to du | rable physica | l objects | , relevoni | monuments | and phys | ical condit | ions that w | T I I V |
| | | , | | | | | | | | | SECT | 10N 3 | | |
| | | | | | | | | | | | | | z | |
| | | | Coff | | Ι, | <u> </u> | | | | Cor () | 2 | | 94 | |
| | | | Δ | | WIZA | | | | | | + | # 7 + - 4 | <u>a'</u> | |
| | | | ব | | | . P&C IOT | | (7) | | cor B sec y | 4 | 3 14 3 13 ⁴ W ⁸¹ | 5 B | |
| | | | 681.64 | | LED | SABLE | | W COR. | | | F | (6) | | |
| | | | 168 | | | | | /4-SE1 P&C #8 | | | ĮΝΕ1. | E COR. /4-SE1/4 | 1 | A |
| | | | | | POL. | FND. | | J 394 | .67 | P&0 #865 | is 01 | P&C #865 N SPLIT, " | 6 | \mathbb{A} |
| | | AVE. | ot | | | IPE | | η <u>δ</u> Ε | X 20 | X | 37.1 | 20 ∆ B'' | ? | -/ \ |
| | | | ~ (| | | | | 4 ⊠. | E | 331.30 | | Ø4 CA | | $I\Gamma$ |
| " | , | 1 VANHOE | m | | | | | Pi₄ b | 8C | | | | | |
| FN9 X-NA | ILS | Σ× | 5.59 | | x- | NAILS | 5 | , _{#8} | 656 | FND. X-NAIL | _ | 1323 JASPER | FNO. | . N |
| _P.I | ۲ <u>.</u> | | 97 | | | P.P. | 0. 0 | | | COR. PC | | X | IN P. | F21 1 |
| | | S. | | 160 | , | I/ REE | | 65 F | 1/2" REBAR | | 8 | 0 | 0 | Λ |
| | | G | · · · · · · | > - | | | \$ | 40. | | ^ | • | (a 4). 's | | Ш |
| | | | <u> </u> | / | 260 | 14.87 | ∆ A¤ | | 25.54 | $\frac{\Delta}{A^{lef3}}$ 13 | 325.54 | _ A BOF | 13 | |
| | | | 45 | S, | | | 77 11 | - 5 | 26ØTH 5 | STREET | | | | |
| | | | | |) | | | | | | | و ع | | |
| 1 | 1 | | | | | MILS | (3) | | (4 | 1) | | ASTIC | (5) | _ |
| SW C FND ! | | | | | - | .թ. የ | 51/4 ⁻ COI FND. 1/2 ⁻ 1 | | SW Č SE1/4- | DR. | | Y MARKER GN POST | SÉ COF FND, 5/ | |
| REE | | | | | | | W/ALUM () NOT | AP | | REBAR | # 1 | 5525 | REBAR | ₹ |
| | ŀ | | | | | | LEDGABL | E. | LEDG | | | | | |
| l hei | reby | certi | fy that | th | e sur | vey w | เอโสรสเลา | | | List of | Corne | rs to be | Indexed | |
| сотр | leted | and | this ce | rti | flcat | e wos | grepered | 59.4 | | | | | | |
| me or | r und | er my | direct | ре | rsona | i Sug | eryjsion. | X Co | ners | | Section | | wp. 94N | Range |
| | | | | | | F27 0 | a Surveyor | | SW COR. W1/4 CC | | | 3 3 | 94N | 13W |
| under the laws of the State of lowa、文字符 :((3): 51/4 CDR. 3 94N 13W | | | | | | | | | 13W 13W | | | | | |
| Signoture: 3 94N 13W | | | | | | | | | | | | | | |
| Robert L. Holze SW COR NMI/4-SE1/4 3 94N 13W | | | | | | | | | | | | | | |
| Dote: 116 2003 Reg. No. 8656 281715152648 | | | | | | | | | | | | | | |
| | ٠, | . ' | | | _ | | | | | Filed | 2- | 20-03 | | |

My registration reneval date is December 31, 2003.