Chickasaw Co. Recorder Cindy Messersmith Fee Book 2013-1126 07/11/2013 @0105PM SCC SEC COR CERT BOOK: Page: \$7.00 # Pages: 1

Preparad by & Raturn to: Harold - Raicks Survaying, 19 East Main Street, Nau Hampton, 19 506561, Ph. 641-994-2725

UNITED STATES PUBLIC LAND SURVEY CORNER CERTIFICATE

Land Survey Monuments situated in Section 30, Township 94 North, Range 12 West of the Fifth Principal Meridian, Chickasaw County, Iowa. 1.) Previously recorded in Doc. #2008-1525 in the County Recorder's office. 2.) Not previously recorded in the County Recorder's office.

This certificate is being prepared in compliance with Iowa Code Chapter 355.11 because:


- 2 X There is no certificate on file for this corner.
 - There are no longer three valid ties of record. There are changes to reference ties of record.
- There is change of monumentation of record. 1 X
 - □ To clarify description of record monument (tles).

Monument Description and Remarks:

- 1.) Northwest Corner SW 1/4-NW 1/4: Set Survey Mark Nail w/Stainless Steel Washer PLS 15525 from ties, as shown on previous Section Corner Certificate.
- 2.) Northeast Corner SE 1/4-NW 1/4: Set 5/8"Ø rebar w/2"Ø aluminum cap PLS 15525 equidistant between the North 1/4 and Center of Section 30.

PLAN - VIEW

(Show a minimum of three reference ties to durable physical objects, relevant monuments and physical conditions that will enable recovery of the corner.)

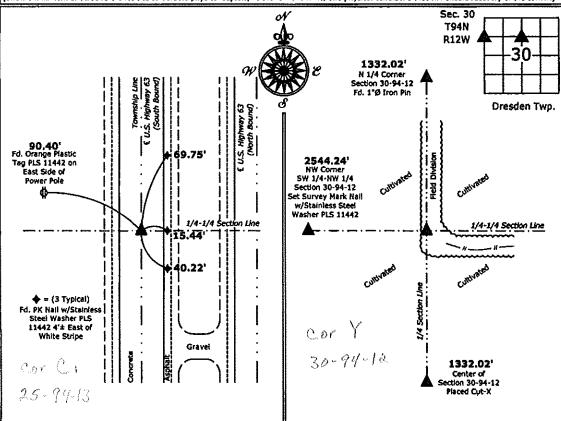

1.) Northwest Corner SW 1/4-NW 1/4 Section 30-94-12 Set Survey Mark Nail w/Stainless Steel Washer PLS 15525

2.) Northeast Corner SE 1/4-NW 1/4 Section 30-94-12 Set 5/8"Ø rebar w/2"Ø aluminum cap PLS 15525

Section

Comers



I hereby certify that this land surveying document was prepared and the related survey work was performed by me or under my direct personal supervision and that I am a duly licensed Land Surveyor under the laws of the State of Iowa.

Your R. Hewel 7-11-12 Paul R. Herold Date:

License number 15525 My license renewal date is December 31, 2014. Sheets covered by this seal: Individual sheet only

	AAA AAA	ber: 2013-075 ounty 5, Pgs. 50	-51
NE-SE-NW	30	94	12
NW-SW-NW	30	94	12

List Corners to be Indexed

Projects\2013\2013-075\2013-075.dwg, 6/20/2013 3:29:25 PM 8

ŝ

Range

Section 35-94-13

As referred to in Chickasaw Co. Recorder Cindy Messersmith

Fee Book 2008-1525

OB/06/2008 @100BAM

SEC OR CERT

Book: Fage: \$7.00

#

Pages: 1

Prepared by: Erdman Engineering, P.C., 708 Commerce Drive, P.O. Box 246, Decoroh, lowa 52101 (563) 382-4194

United States Public Land Survey Corner Certificate of 25

Land Survey Monuments situated in Section 30., Township 94., Range 12 West of the 5th Principal Meridian in Chickasaw County, lowa. Previously recorded in does not apply in the county Recorder's Office.

Monument Description and Remarks: This certificate is prepared in accordance with Section 193C of the Code of lowo. No previous certificate has been filed for this corner location. We found no record of the WNW 1/2 Corner being set. We found no evidence of a monument in the field other than the highway. We found the W ½ Corner and the NW Corner. We set a Mag-noil with 1 ½" diameter stainless steel washer #11442 on line and equidistant between the W ½ Corner and the NW Corner as the WNW 1/8 Corner of Section 30, Township 94 North, Range 12 West.

Plan-View



Set P.K. nail with 1" diameter aluminum washer #11442 ±4' east white stripe at end of Nail with orange rumble strip plastic cap #11442 on east side of utility pole 90.40, Set P.K. noil with 1" diameter aluminum washer #11442 ± 4 east of white stripe 15.44 **C** crushed rock drive Highway Surface Set P.K. nail with 1" diameter aluminum washer #11442 ±4' east of white stripe at PROMAN approximate centerline crushed rock driveway Cor C1 25-94-13 AWOLUN

I hereby certify that this land surveying document was prepared and the related survey work was performed by me or under my direct personal supervision and that I am duly licensed Land Surveyor under the laws of the State of lowa.

Signature P.E. and P.L.S. Jowa License Number 11442 Lindagy Erdmon.

My license renewal date is December 31, 2008

Corner(s) to be Indexed

Corner Section Township Ronge 12

WNW 1/8