Preparad by & Ratum to: Harold - Racks Surveying, 10 East Main Street, New Hampton, IA 56659, Ph. 64-994-2725

## UNITED STATES PUBLIC LAND SURVEY CORNER CERTIFICATE


Land Survey Monuments situated in Section 8, Township 94 North, Range 13 West of the Fifth Principal Meridian, Chickasaw County, Iowa. 1., 2.) Previously recorded in Bk. 157, Pg. 381 in the County Recorder's office.

This certificate is being prepared in compliance with Iowa Code Chapter 355.11 because:

☐ There is no certificate on file for this corner.
☐ There are no longer three valid ties of record.
☐ There are changes to reference ties of record.
☐ There is change of monumentation of record.
☐ To clarify description of record monument (ties).

Monument Description and Remarks:

- 1.) East 1/4 Corner: Found 1/2"Ø rebar from information obtained from the previous Section Corner Certificate, all tie were missing, set new ties to update corner.
- 2.) Southeast Corner: Set Survey Mark Nail w/Stainless Steel Washer PLS 15525 from information obtained from the IDOT District Office.

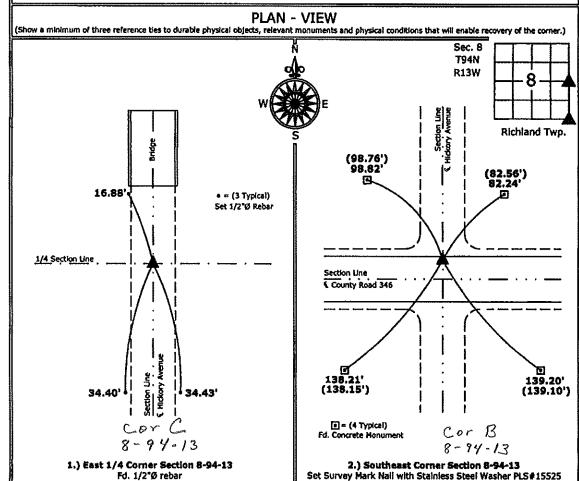



I hereby certify that this land surveying document was prepared and the related survey work was performed by me or under my direct personal supervision and that I am a duly licensed Land Surveyor under the laws of the State of Iowa.

Paul R. Herold Date:

License number 15525

My license renewal date is December 31, 2012. Sheets covered by this seal: Individual sheet only

List Corners to be Indexed				
Corners	Section	Twp.	Range	
E 1/4	8	94	13	
SE	8	94	13	
			*/*****************************	
Project Number: 2012-4				
FB: Chickesaw County 4, Pgs. 26, 27				

\2012\2012-004\\_HRS\SCC Dwg\2012-004-SCC.dwg, 1/13/2012 10:42:2

## UNITED STATES PUBLIC LAND SURVEY CORNER CERTIFICATE

OF

Proviously seemed 1.1 to the Pirth Principal Meridian, C	
(Show reason for preparing this certificate, the evidence and detailed presentation found or placed.)  Monument Description and Remarks: see	•
PLAN - VI	EW
(Show a minimum of three reference ties to durable physical objects, re recovery of the corner.)	levant monuments and physical conditions that will enable
	.20' NE to nail od curb bridge
50.25' אי אי אי nail power pole	Cor. C East 1/4 cor. found 1/2" rebar
78.05' NW to "x" nails power pole	
48.00' "x" nails stop sign 11.3	75.35' NE to "x" nails power pole Cor B 5' north of centerline
Southeast co	nterline Highway 346 rner disc in paving
I hereby certify that the survey work was completed and this land surveying document was prepared by me or under my direct personal supervision and that I am a duly registered land surveyor under the laws of the state of lowa	List Corners to be Indexed Corners Section Twp Range
Signature: True Ducce.  Name typed or printed: STEVE BUSSE	SE cor. 8 94 13 East 1/4 cor. 8 94 13
Date: 4/24/95 Reg. No. 9018  My registration renewal date is December 31, 1996	Placed in the Book 5/3/95
SEAL	Book 5/3/95