Chickasaw Co. Recorder Cindy Messersmith Fee Book 2008-2240

11/26/2008 @1015AM SCC SEC COR CERT Book: Page: Total Fees: \$7.00

# Pages: 1

Herold - Reacks Surveying, 25 1/2 East Main Street, Suite 204, New Hampton, IA 50659, Ph. 64-394-2725

## UNITED STATES PUBLIC LAND SURVEY CORNER CERTIFICATE Land Survey Monuments situated in Section 14, Township 95 North, Range 11 West of the Fifth Principal Meridian, Chickasaw County, Iowa. Previously recorded in 1.) none 2.) Bk. 161, Pg. 89 in the County recorder's office.


This certificate is being prepared in compliance with Iowa Code Chapter 355.11 because:

1. \( \) There is no certificate on file for this corner.
2. \( \) There are no longer three valid ties of record.
There are changes to reference ties of record.
There is change of monumentation of record.
To clarify description of record monument (ties).

Monument Description and Remarks:

**S 1/4 Corner** - Fd. 3/4" Sq. Iron bar (2' deep) at the Centerline of 220th Street from Information obtained from the Chickasaw County Engineer's office in Field Book "Stapleton Twp.", Section 14, Corner A. Set 5/8'Ø rebar w/2"Ø aluminum cap PLS 15525 over top.

**E 1/4 Corner** - Fd. 1/2\* Sq. Twisted Iron bar from previous corner certificate. Previous ties were missing. Set three new ties to update the corner.

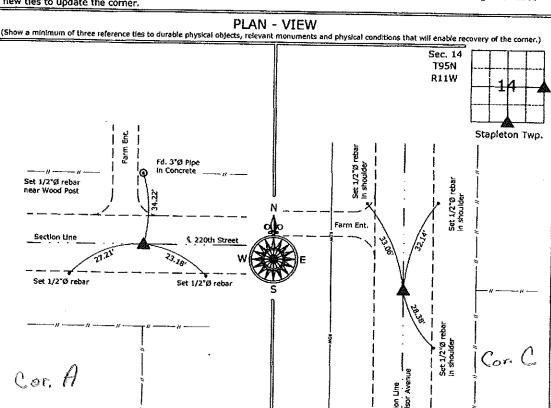

1.) S 1/4 Corner Section 14-95-11 Fd. 3/4" Sq. Iron bar (2' deep) Set 5/8"Ø rebar w/2"Ø aluminum cap PLS 15525 over top

2.) E 1/4 Corner Section 14-95-11 Fd. 1/2" Sq. Twisted Iron bar

PAUL R. HEROLD 15525

I hereby certify that this land surveying document was prepared and the related survey work was performed by me or under my direct personal supervision and that I am a duly licensed Land Surveyor under the laws of the State of Iowa.

Paul R. Herold 11-26-08
Date:
Ucense number 15525

My license renewal date is December 31, 2008. Sheets covered by this seal: Individual sheet only

List Corners to be Indexed					:
Comers	Section	Twp.		Range	18
5 1/4	14	95		11	į
E 1/4	14	95		11	
					1
				i	٥

Project Number: 2008-078 F8: Chickasaw County 1, Pgs. 78-79 Section 14-95-11
As reserred to in
Engli Tie Book

PAUL H. HELLAND, 2322 W. 1ST ST., SUITE B, CEDAR FALLS, 10WA 50613, (319)-266-0161					
UNITED STATES PUBLIC LAND SURVEY CORNER CERTIFICATE OF					
Land Survey Monuments situated in Section 13 14 Township 95 Range  // of the Fifth Principal Meridian, Chickasaw County, Iowa.					
Previously recorded in Book, Page County, Iowa.					
(Show reason for preparing this certificate, the evidence and detailed procedures used in establishing the corner positions and monumentation found or placed.)					
Monument Description and Remarks: Survey of 5 1/2 sw 1/4 Sec. 13.  W 1/4 (OK Found 1/2" of Twist pin 0:8' Deep  SW (Or - Found nail wlflagging 0.3' Deep					
PLAN - VIEW					
(Show a minimum of three reference ties to durable physical object enable recovery of the comer.)	ts, relevant monuments and physical conditions that will				
53	& LANDA				
J. J. see.	·····				
PAUL H. HELLAND					
l u .	5505				
W. * *	Acces * * A				
Reaca	OWA Utility Pole				
Brace Post	w/x/				
witag   *	intop				
52.99	* - } -				
Gate Host 52.16 C.P.	10,18				
WI+ag WI+ag	44.34'				
C.P. witag					
V 11 / V	CP CP				
W 14 CORNER	w/tag				
Ca C1495-14	SW CORNER X				
•	Cor B 14 95-11				
96 - 231	7. 70 77				
I HEREBY CERTIFY THAT THIS PLAT, MAP, SURVEY OR REPORT WAS MADE BY ME OR UNDER MY DIRECT PERSONAL SUPERVISION AND THAT I AM A DULY REGISTERED LAND SURVEYOR ENDER THE LAWS OF THE STATE OF JOHA	List Corners to be Indexed				
MALE DATE DE STORE DE	Corners Section Twp Range  W// 13 95 //				
THUNDER RIDGE BANK BUILDING SW 13 95					
11 S 2322 WEST 1ST ST., SUITE B CEDAR FALLS, 10WA 50613 319-266-0161 0/1					
HELLAND ENGINEERING & SURVEYING, LTD.	Placed in to Brok				
Eng, Capp. 161-89	/ / a/				