Chickasaw Co. Recorder Fee Book 2007/30/2015 @1049AM SCC. SEC COR CERT Page: \$7.00 Fee Book 2015-0981 # Pages: 1

Prepared by & Return to: Herold - Reicks Surveying, 10 East Main Street, New Hampton, 19 50659, Ph. 641-394-2725

UNITED STATES PUBLIC LAND SURVEY CORNER CERTIFICATE

Land Survey Monuments situated in Section 18, Township 95 North, Range 11 West of the Fifth Principal Meridian, Chickasaw County, Iowa. 1.) Previously recorded in Document #2002-2124 in the County Recorder's office. 2.) Previously recorded in Bk. 160, Pg. 430 in the County Recorder's office.

This certificate is being prepared in compliance with Iowa Code Chapter 355.11 because:


☐ There is no certificate on file for this corner. There are no longer three valid ties of record. There are changes to reference ties of record. There is change of monumentation of record. To clarify description of record monument (ties).

Monument Description and Remarks:

- 1.) North 1/4 Corner: Set 1"Ø Bronze Survey Marker PLS 19211 at previous location (Found Lead Plug w/Cut-X) with coordinates obtained prior to highway reconstruction, Project #STP-S-CO19(94)--5E-19.
- 2.) South 1/4 Corner: Set 1"Ø Bronze Survey Marker PLS 19211 at previous location (Found Cut-X) with coordinates obtained prior to highway reconstruction, Project #STP-S-CO19(94)--5E-19.

PLAN - VIEW

(Show a minimum of three reference ties to durable physical objects, relevant monuments and physical conditions that will enable recovery of the corner.)

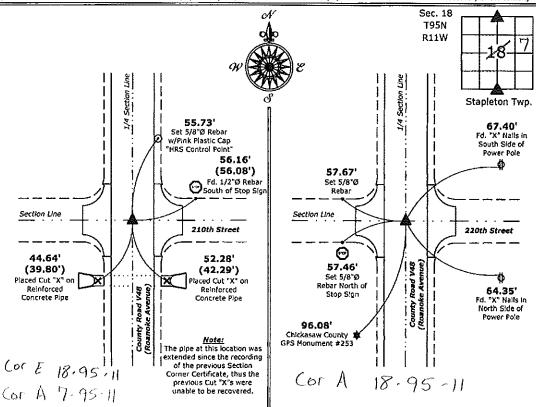

1.) North 1/4 Corner Section 18-95-11 Set 1*Ø Bronze Survey Marker PLS 19211

2.) South 1/4 Corner Section 18-95-11 Set 1"Ø Bronze Survey Marker PLS 19211



I hereby certify that this land surveying document was prepared and the related survey work was performed by me or under my direct personal supervision and that I am a duly licensed Land Surveyor under the laws of the State of Iowa.

Kirk D. Reicks Date:

License number 19211 My license renewal date is December 31, 2016. Sheets covered by this seal: Individual sheet only

List Corners to be Indexed					
Corners	Section	Twp.	Range		
N 1/4	18	95	11		
\$ 1/4	18	95	11		

Projects\2015\2015-001 (V48)\2015-001.dwg, 7/29/2015 10:23:30 AM

S:C3D

Project Number: 2015-001 FB: Chickasaw County 7, Pg. 24

FILED 2002 - 2124 RECORDER'S OFFICE CHICKASAW COUNTY, IOWA

2002 AUG 30 AM 10 32

OHDY MESSERSMITH COUNTY RECORDER

TEKIPPE ENGINEERING, P.C., 128 South Vine Street, West Union, Iowa 52175 Phone (563) 422-5131 UNITED STATES PUBLIC LAND SURVEY CORNER CERTIFICATE 95 North, Range __ , Township _ Land Survey Monuments situated in Section _ CHICKASAW West of the Fifth Principal Meridian, County, Iowa. in County Recorder's Office. none Previously recorded in ___ (book, page, document number, etc.) (Show reason for preparing this certificate, the evidence and detailed procedures used in establishing the corner positions and monumentation found or placed.) Monument Description and Remarks: S 1/4 Corner Section 7 T95N R11W: Found lead plug with information obtained from a Survey and Plat made by L. P. Erdman recorded in the Chickasaw County Recorder's Office March 1, 1976 in Book 111, Page 79. Placed cut-X over lead plug. SE Corner Section 7 T95N R11W: Set 1/2" o rebar w/2" o aluminum cap PLS 15525 on the centerline of County Road 210th St. on the extension of the Section Line fence from the North. Project Number 02193.IS PLAN - VIEW (Show a minimum of three reference ties to durable physical objects, relevant monuments and physical conditions that will enable recovery of the corner.) Sec. 7 T95N RIIW Stapleton Twp. Set 1/2"¢ rebar across from STOP Set 1/2"¢ rebar NOTE: Corner Is 1'± West of Centerline Joint а 56.08 210th St. 210th St. Section Line Section Line Line ⊞ Ploced cut-X 1/2 ¢ 1/2"ø rebor Rd. Placed cut—X top of 36°¢ RCP culvert Sec. top of 36"¢ RCP culvert <u>ල්</u> 1/4 Ave. Cor B € Roanoke Cor A



I hereby certify that this land surveying document was prepared and the related survey work was performed by me or under my direct personal supervision and that I am a duly licensed I and Surveyor under the laws of the State of Iowa.

S 1/4 Corner Section 7 T95N R11W

Found lead plug, placed cut-X over plug

Sona R. Herold 8-29-02

Paul R. Herold	Date	
License number 16525		
My license renewal date is	December 31, 2002.	
Sheets covered by this see	al: Individual	

Corners	List Corners to Section	be Indexe Twp.	d Range			
S 1/4	7	95N	11W			
· SE	7 File 9-	95N 5-02	11W			
X:\Section Comers\Sec. 07\7-95-11wy.dwg						

SE Corner Section 7 T95N R11W

Set 1/2"ø rebar w/2"ø aluminum cap PLS 15525

