
Chickasaw Co. Recorder Cindy Messersmith Fee Book 2012-0390 Fee Book 20128AM 02/24/2012 @1128AM SEC COR CERT Page: \$7.00 # Pages: 1

X:\Section Corners\Sec. 04\4-95-11QV.dwg

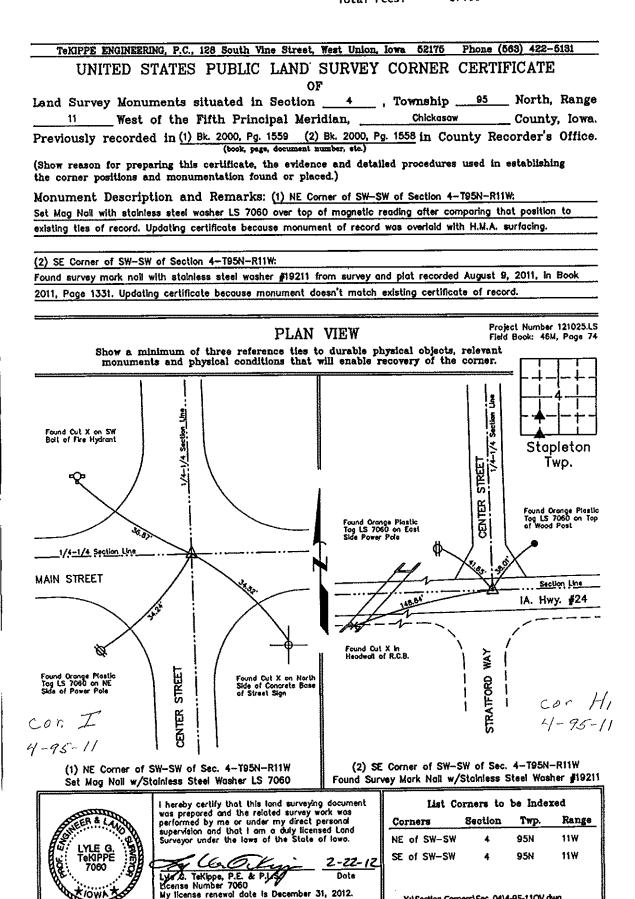

Sheets covered by this seal: This Sheet Only

TEKIPPE ENGINEERING, P.C., 128 South Vine Street, West Union, Iowa 52175 Phone (319) 422-5131 UNITED STATES PUBLIC LAND SURVEY CORNER CERTIFICATE OF __ , Township _ Land Survey Monuments situated in Section __ North, Range ____ West of the Fifth Principal Meridian, CHICKASAW County, Iowa. none Previously recorded in in County Recorder's Office. (book, page, document number, etc.) (Show reason for preparing this certificate, the evidence and detailed procedures used in establishing the corner positions and monumentation found or placed.) Monument Description and Remarks: NW Corner SW 1/4 - SW 1/4 Section 4 T95N R11W: Set 1/2"ø rebar w/2"ø aluminum cap LS 7060 equidistant and on line between the SW Corner and the W 1/4 Corner of Section 4. SE Corner SW 1/4 - SW 1/4 Section 4 T95N R11W: Set MAG nail w/stainless steel washer LS 7060 at the intersection of the centerline of Center St. with the centerline of Iowa Hwy. 24 as indicated in the Road Record found in the Chickasaw County Engineer's Office. Project Number 00167.IS PLAN - VIEW FR. 46H PG. 4-17 (Show a minimum of three reference ties to durable physical objects, relevant monuments and physical conditions that will enable recovery of the corner.) Sec. 4 T95N R11W Stapleton Twp. Set orange plastic tag LS 7060 top of exposed root South ₹ Set orange plastic tag LS 7060 East Center Set orange plastic tag LS 7060 top side 48"ø Mople side power pole wood tel-ped post ಭ McHugh <u>lowa Hwy. 24</u> Section Line Cut-X top Set orange plastic tag LS 7060 concrete pipe Found cut-X Found iron pin headwall of in headwall of RC box culvert RC box 48"ø Maple culvert Section cor Hi Stratford Cor Bi 5-95-11 NW Corner SW 1/4 - SW 1/4 Section 4 T95N R11W SE Corner SW 1/4 - SW 1/4 Section 4 T95N R11W Set 1/2"ø rebar w/2"ø aluminum cap LS 7060 Set MAG noil w/stainless steel washer LS 7060 List Corners to be Indexed I hereby certify that this land surveying document was prepared and the related survey work was Corners Section Range performed by me or under my direct personal

NW-SW-SW

SE~SW-SW

9-6-00

supervision and that I am a duly licensed Land Surveyor under the laws of the State of Iowa.

My license renewal date is December 31, 2000. Sheets covered by this seal: Individual

Lyle G. TeKippe License number 7060 95

11

11