Instrument #: 2020-1252
06/19/2020 02:49:11 PM Total Pages: 1
SCC SECTION CORNER CERTIFICATES
Recording Fee: \$ 7.00
Shirley Troyna, Recorder, Chickasaw County Iowa

Project Number: 2019-810

FB: 2019 Construction, Pgs. 14-36

Prepared by & Return to: Heroid - Reicks Surveying, IO East Main Street, New Hampton, IA 50659, Ph. 641-394-2725 United States Public Land Survey Corner Certificate Land Survey Monument situated in Section 28, Township 97 North, Range 11 West of the Fifth Principal Meridian, Chickasaw County, Iowa. On file in Document #2002-1924 in the County Recorder's office. There is no certificate on file for this corner. This certificate is being prepared in compliance There are no longer three valid ties of record. with Iowa Code Chapter 355.11 because: There are changes to reference ties of record. There is change of monumentation of record. To clarify description of record monument (ties). Monument Description and Remarks: Southeast Corner: Set 1"Ø Bronze Survey Marker PLS 19211 at previous location (Found PK Nail) with coordinates of the Corner obtained prior to highway reconstruction, Project No. FM-C019(89)--55-19. Plan View (Show a minimum of three reference ties to durable physical objects, relevant monuments and physical conditions that will enable recovery of the corner.) Sec. 28 T97N **R11W** 28 Set 5/8*Ø Rebar in Shoulder across from "V56" Sign 89.06 Control Systems - NHO\CHICKASAW\CHICK-7\CHICK-7 - 2020.dwg, 6/16/2020 11:13:22 Set 5/8"Ø Rebar In Shoulder across from ⊚ 53.42 County Road B22 (120th St.) Section Line (120th St.) HMA ρ_{CC} ⊚ 57.40 Set 5/8"Ø Rebar in Shoulder across from Stop Sign County Road VS6 (Union Avenue) Cor. B-28-97-11 Southeast Corner of Section 28-97-11 Set 1"Ø Bronze Survey Marker PLS 19211 NHO\County List Corner to be Indexed I hereby certify that this land surveying document was prepared and the related survey work was Section Twp. Range Corner performed by me or under my direct personal supervision and that I am a duly licensed Land SE 28 97 11 Surveyor under the laws of the State of Iowa. KIRK D. b 6-17-20 Kirk D. Relcks Date:

License number 19211

William .

My license renewal date is December 31, 2020. Sheets covered by this seal: Individual sheet only




TEKIPPE ENGINEERING, P.C., 128 South Vine Street, West Union, Iowa 52175 Phone (563) 422-5131

UNITED) STATES PUBLIC LAND	POKAFI	CORNER	TRIVITIE TOWN	ندا	
	01	_P				
	-		, Township _	97Nort	h, Range	
land Survey Monuments studted in Section					nty, Iowa.	
	est of the Fifth Principal Mer	idian,			•	
Previously reco	orded in	number etc.)	in Cou	nty Recorder	's Office.	
	preparing this certificate, the eviden		iled procedures	used in establi	shing	
the corner position	ns and monumentation found or place	cea.)				
Monument Des	cription and Remarks: S 1/4	Corner Sec	ction 28 1971	RIII: Found	ld Pa llair	
with information	on obtained from the Chickas	aw County	Engineer's	Office in Fie	IG BOOK	
Utica North Tv	vp. Corner Ties, Section 28, C	orner 'A'.				
				11.		
SE Corner Sec	tion 28 T97N R11W: Found PK	nail with	information	obtained ire	m the	
Chickasaw Cou	nty Engineer's Office in Field	Book Utic	ea North Twp	. Corner 11e	s, section	
28, Corner 'B'.						
	—————————————————————————————————————	- VIEW		Project Nun FB. 46J I	nber 02179.LS PG. 22-23	
(a)	of three reference ties to durable		ects, relevant m			
conditions that w	ill enable recovery of the corner.)	P22 /22222				
		<u> </u>		Sec. 28	↓ - - ↓ - 	
			!	T97N		
				R11W		
		Į.	Į	[]	1-1-1	
		il i		Utica	a North Tw	
		1	1	(56)		
	Found 1/2" square		}			
	twisted iron bar	i		Union Ave. (Co. Rd. Section Line	1	
Found 1"Ø	50.12. 19.60		/II	Section	1	
pipe 	13, 13,	<u> </u>	<u></u>	/ * 8	L_\\	
400% & 70- B4 B0	223	₩	Set MAG not	, pic	35 / Fou	
120th St. (Co. Rd. B2 Section Line		(——	ACC return 5;	209,	60.35 Fou squ Iron	
Section Line	\$ 62.53,		St. (Co. Rd. B22)			
	-\ \		Section Line			
±OE	ا ق ا					
Found X-neils	Found 1"s	II 1	00.00		,,	
NE side power pole	i I	•			["-	
		Found 1" square		\	1	
. .	Δ	iron bar	0		1	
Con	; / 7	1	cor, B		1	
					Ì	
C 1/4	Corner Section 28 T97N R11W		SE Corner Secti	on 28 T97N R11	w	
5 1/4	Found PK nail	3		PK noil		
	I hereby certify that this land surveying door	ıment.	List Corner	s to be Indexe	đ	
A COUNTY OF THE PARTY OF THE PA	was prepared and the related survey work we	s Corn	ers Section	Twp.	Range	
AND SEA	performed by me or under my direct persons supervision and that I am a duly licensed La	nd	/* 09	97N	11W	
PAUL R.	Surveyor under the laws of the State of lowe	. S 1/	/4 28	3714	t 1 11	
HEROLD OF	Paul P. Hendel R-7-	02				
15525	Paul R. Herold Date	SE	28	97N	11W	
* / OW * *	License number 15525	<u>.</u>	File	8-7-02		
My license renewal date is December 31, 2002. Sheets covered by this seal: Individual			X:\Section Corners\Sec. 28\28-97-11wy.dwg			

X:\Section Corners\Sec. 28\28-97-11wy.dwg

COUNTY ENGINEER'S SECTION CORNER PRESERVATION RECORD

land survey monument located in section 28, township $97\ N$ north, range $11\ W$, of the 5th p.m. Chickgsqw county, iowa previously recorded $8k\ 2002\ - Pg\ 1924$.

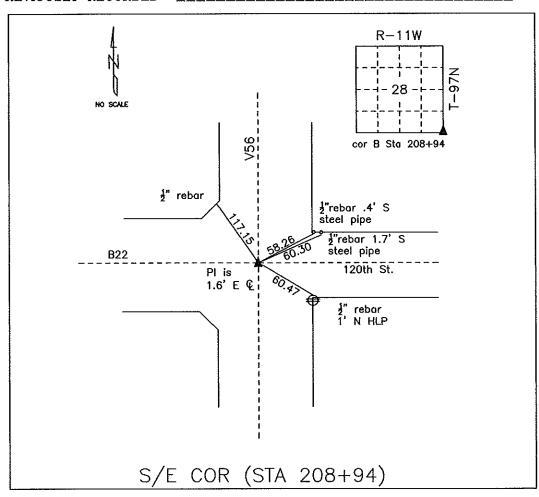

MONUMENT DESCRIPTION AND NARRATIVE Found PK noil in HMA mot
From Chickasaw County Project plans SN-188(9) found Pl is 1.6' east of center line. Information was also
found in the county engineer tie book.
All ties are GPS surveyed.
I AM NOT A REGISTERED LAND SURVEYOR UNDER THE LAWS OF THE STATE OF IOWA
JIM FOSTER CHICKASAW CO. DATE: 08/03/10