


# COUNTY ENGINEER'S SECTION CORNER PRESERVATION RECORD

LAND SURVEY MONUMENT LOCATED IN SECTION 27, TOWNSHIP 97 N  
NORTH, RANGE 11 W, OF THE 5TH P.M. Chickasaw COUNTY, IOWA  
PREVIOUSLY RECORDED FILE 2002-0202

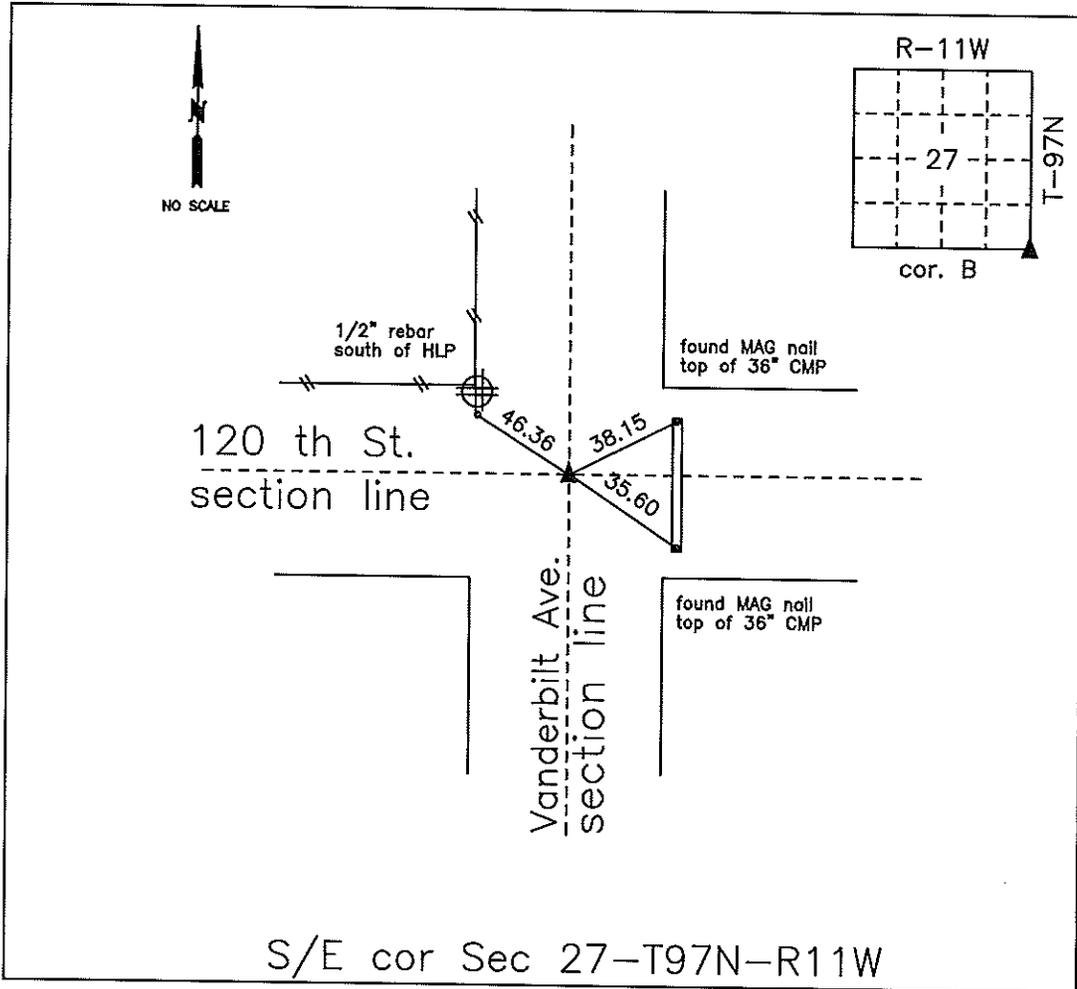

**MONUMENT DESCRIPTION AND NARRATIVE** Found iron pin in center of road in line with both roads north/south & east/west from county engineer ties. 3 ties were missing. Set 1 rebar w/caps south of power pole at n/w cor of intersection.

All ties are GPS surveyed.

I AM NOT A REGISTERED LAND SURVEYOR UNDER THE LAWS OF THE STATE OF IOWA

JIM FOSTER CHICKASAW CO. DATE: 11/10/13

Corner B  
 Section 27-97-11  
 As referred to in  
 Engr. Tie Book.

FILED 2002-0202  
 RECORDER'S OFFICE  
 CHICKASAW COUNTY, IOWA  
 2002 JAN 23 AM 9 01  
 CINDY MESSERSMITH  
 COUNTY RECORDER

TEKIPPE ENGINEERING, P.C., 128 South Vine Street, West Union, Iowa 52175 Phone (563) 422-5131

UNITED STATES PUBLIC LAND SURVEY CORNER CERTIFICATE

OF

Land Survey Monuments situated in Section 34, Township 97 North, Range 11 West of the Fifth Principal Meridian, CHICKASAW County, Iowa.

Previously recorded in none in County Recorder's Office.  
(book, page, document number, etc.)

(Show reason for preparing this certificate, the evidence and detailed procedures used in establishing the corner positions and monumentation found or placed.)



Monument Description and Remarks: NE Corner Section 34 T97N R11W: Found 1/2"Ø iron pin, 12" deep, with information obtained from the Chickasaw County Engineer's Office in Field Book Upper Utica Twp., Section 27, Corner 'B'. Set 1/2"Ø rebar w/2"Ø aluminum cap PLS 15525 over pin.

E 1/4 Corner Section 34 T97N R11W: Set 1/2"Ø rebar w/2"Ø aluminum cap PLS 15525 on the split of R.O.W. on the extension of a line from the W 1/4 Corner through a 1/4 Section Line fence.

PLAN - VIEW

Project Number 01245.LS  
 FB. 461 PG. 54-58

(Show a minimum of three reference ties to durable physical objects, relevant monuments and physical conditions that will enable recovery of the corner.)

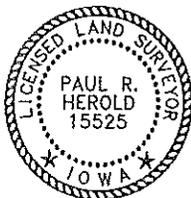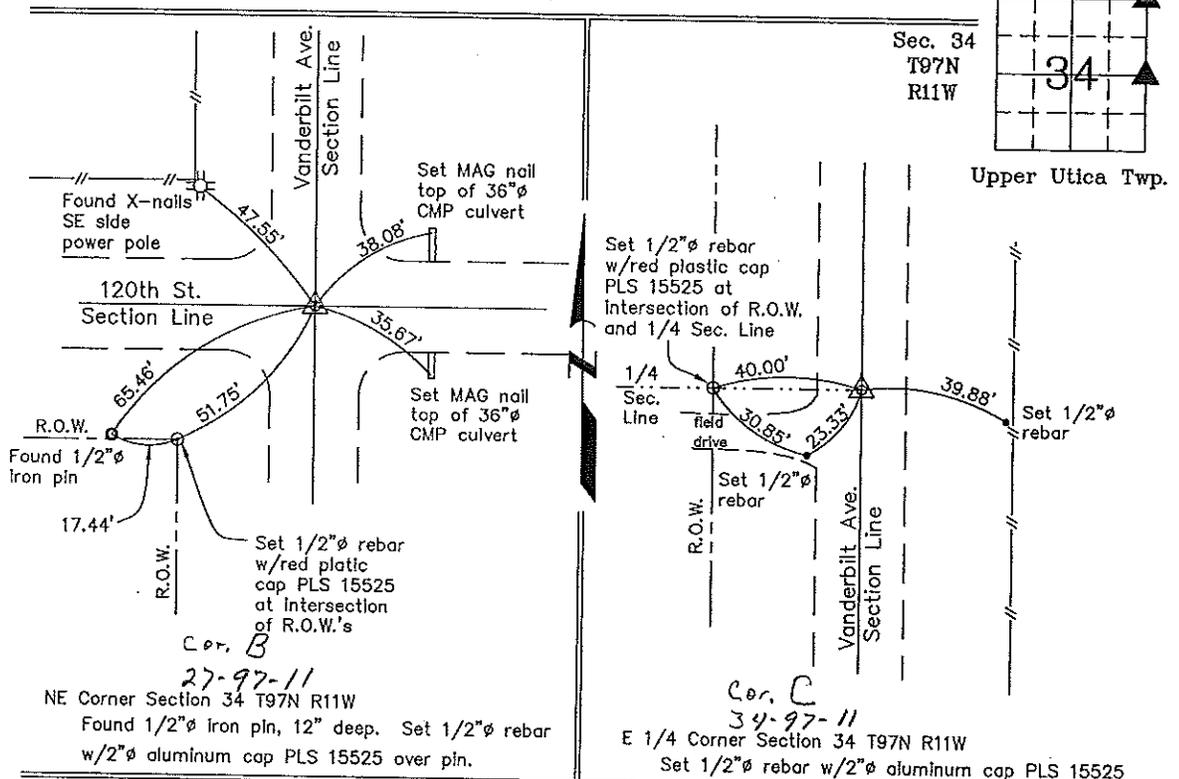

I hereby certify that this land surveying document was prepared and the related survey work was performed by me or under my direct personal supervision and that I am a duly licensed Land Surveyor under the laws of the State of Iowa.

Paul R. Herold 1-22-02  
 Paul R. Herold Date  
 License number 15525  
 My license renewal date is December 31, 2002.  
 Sheets covered by this seal: Individual

List Corners to be Indexed			
Corners	Section	Twp.	Range
NE	34	97N	11W
E 1/4	34	97N	11W

Entered 1-29-02

County Engineer's  
 Office