
Instrument #: 2022-1898
10/14/2022 03:34:21 PM Total Pages: 1
SCC SECTION CORNER CERTIFICATES
Recording Fee: \$ 7.00
Shirley Troyna, Recorder, Chickasaw County Iowa

Prepared by: <u>Kyle</u>	A. Johnson	Address: <u>190</u>	O MEDICAL ARTS AVE S. SUITE 100 SAR	TELL. MN	Phone: <u>1-888-937-5150</u>
	UN	IITED STATES PUR	LIC LAND SURVEY CORNER	CERTIFICATE FO	OR.
Land survey monume					
			, of the Fifth Principal Meridian,		
Previously Recorded	in				in County Recorder's Office.
(Show reason for pr	reparing this certificate, the o	evidence and detailed procedures	used in establishing the corner positions and mon	umentation found or placed.)	
MONUMENT DESCRI	IPTION AND REMARK	S:			
NORTHWEST CO corner record. Acc	DRNER : Westwood cepting corner locat	Professional Services for Fion and set 2 ties. Filin	ound a 1/2" iron rod with illegible o g corner record as there are no lon	cap 0.5' deep, 1 tie p ger 3 valid ties of re	er engineers tie book, and 2010 cord.
SOUTH QUARTE agree with previo	ER: Westwood Profe us records. Acceptir	ssional Services found ng corner location and	a 1/2" rebar 0.1' deep and 1 tie of p set 2 ties. Filing corner record as th	previous record. Dist ere are no longer th	ances agree to controlling corners ree valid ties of record.
			PLAN - VIEW		
(Show a minimum of t	hree reference ties to dure	able physical objects, relevant i	monuments and physical conditions that will e	nable recovery of the corne	er.)
		<i>I QUARTER</i> NT 1/2IN REBAR	Cor. A 33-97-13		
		φ		•	
		2.72 2.72			
					33
	, /	^ _			
	51 ^{A*} \\\\\\\\\\\\\\\\\\\\\\\\\\\\\\\\\\\\	STOTH ST STORY	<u>. </u>		_
	401 XV	09.03	, j.O.1		
	T MAG NAIL POWER POLE		SET MAG NAIL		
114	FOWER FOLE		IN POWER POLE		\mathbf{N}
					<u>,</u>
NORTHWEST CORNER					
SET MAG NAIL IN POWER POLE 1					
		2° <u>W</u>	SET MAG NAIL IN PRAOD SIGN POST		Y
		\ \frac{\chi}{\pi}	3.15		N.T.S.
		\ <u>{</u>	∛		
		· √			
		•	<u> </u>		
			120TH ST		
			\$50°E \$9,45		
			3.45 OF	DUND X NAIL IN NO	
			HICKOK AVE	DE OF 4IN WOOD F	2 021

Cor. B 29-97-13

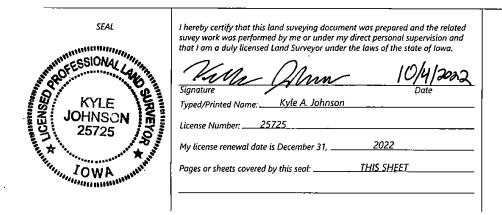

Corners to be Indexed Range Corners Section 33 13 SQ 97 13 33