
Instrument #: 2022-1899
10/14/2022 03:34:21 PM Total Pages: 2
SCC SECTION CORNER CERTIFICATES
Recording Fee: \$ 12.00
Shirley Traying Recorder Chickson County

Shirley 1	froyna, Recorder,	Chickasaw	County Iowa	
	⋰⋒⋎⋭⋒⋰⋉⋞⋪⋰⋷⋪⋒⋰	▃▗▗▗▗▗▗	Ŗĸ₽ĸ₩ĸĸ₽₽ ₽ ₩ĸĸ₩ĸ	
23 1 '∎		MIURI I ITTALI I NAC		

	UNITED STATES PUBL	IC LAND SURVEY CORNER	CERTIFICATE FOR	
d survey monuments situated in Se	ction36		, Township <u>97 NORTH</u>	
Ran	ge <u>13 WEST</u>	, of the Fifth Principal Meridian,	CHICKASAW	———— County, lowa
viously Recorded in			in Cou	nty Recorder's Office.
(Show reason for preparing this certificate,	the evidence and detailed procedures u	ised in establishing the corner positions and mon	umentation found or placed.)	
NUMENT DESCRIPTION AND REMA	ARKS:			
ORTH QUARTER: Westwood P cation and set 1 tie. Filing corne		a 5/8" rebar with cap LS9018 0.4". nger 3 valid ties of record.	deep and 2 ties per 2000 record	Accepting corner
		ound a 5/8" rebar with 2" aluminu g corner location, Filing corner rec		
		PLAN - VIEW		
how a minimum of three reference ties to	durable physical objects, relevant m	onuments and physical conditions that will e	nable recovery of the corner.)	
		N.T.S.		
DRA	NORTHWEST CORNER	FOUND X NAIL I 4IN WOOD POS	NORTH QUARTER NORTH QUARTER X Q FOUND X NAIL I Y Q A IN WOOD POS	
OUND 5/8IN IRON ROD W/ORANGE CAP 188° 33.05	12011	H ST	Na. Na.	
FOUND NAIL AND BOTTLE CAP IN TOP OF LONE SIN WOOD POST S89°W 33.00	FOUND 5/8IN IRON ROD W/ ORANGE CAP		iog s SE	OTH ST T MAG NAIL IN WER POLE
Cor. B [.] 25-	97-13		1	

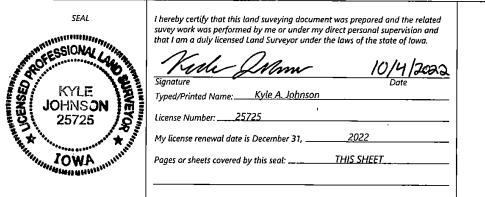

Corners to be indexed				
Corners	Section	Twp.	Range	
NQ	36	97	13	
NW	36	97	13	

PG.1 OF 2

Prepared by: <u>Kyle A. Johnson</u>	Address: <u>1900</u> .	MEDICAL ARTS AVE S, SUITE 100 SARTE	LL. MN Phon	e: <u>1-888-937-5150</u>
UNI	ITED STATES PUBL	IC LAND SURVEY CORNER	CERTIFICATE FOR	
Land survey monuments situated in Section	36	,	ownship 97 NORTH	
Range	13 WEST	, of the Fifth Principal Meridian,	CHICKASAW	County, lowe
Previously Recorded in			ù	n County Recorder's Office.
(Show reason for preparing this certificate, the ev	vidence and detailed procedures us	sed in establishing the corner positions and monun	nentation found or placed.)	
MONUMENT DESCRIPTION AND REMARKS	:			
EAST 16TH CORNER BETWEEN SEC record. Accepting corner location and				deep and 2 ties per 2000
CENTER QUARTER: Westwood Profe engineers tie book agrees closely with there is no certificate on file for this co	n measured distance. Ho			
		PLAN - VIEW		
(Show a minimum of three reference ties to durab	ole physical objects, relevant ma	numents and physical conditions that will ena	ble recovery of the corner.)	
	CENTER QUARTE	•		TN T
	NORTH QUARTE OF SECTION 36	:K		1.
	<u>.</u>			
	N00°5 2644.7			
	58'1 .75			
•	38′11"W			V
	3°5 <u>6'22"</u> W	N88°44'3"E EAST QUARTED OF SECTION 3	₹ 5	N.T.S.
		Of Section 5	5	
	S0°58'1' 2644.75			
	5 ¹¹			
	ϕ			
	SOUTH QUARTE	२		36
	OF SECTION 36			
E	AST 16TH CORNER B	ETWEEN SEC. 25 + 36		
	_	ound "X" nail in	0 44056	7.40
	· () 4	IIN WOOD POST	Cor. A1 25-9	97-13
	32.92 32.92			
		,		
		120TH ST		
	2ºuh	25°C		
FOUND "X" NAIL	5 5 5 5 5 5 5 5 5 5 5 5 5 5 5 5 5 5 5	is in		
FOUND "X" NAIL! IN POWER POLE	\$	SET MAG NAIL IN 3IN WOOD POST		

